

MISSISSIPPI BOARD OF WATER COMMISSIONERS

LEE
B 37
2-73-63

WATER WELL DRILLERS LOG
HERNDON WELL & SUPPLY CO.


Date: Feb 13, 1963, Driller: SHANNON, MISSISSIPPI County Lee

(1) Owner of Land:	Description & Color of Materials Sand, Clay, Red Clay, Shell, etc.	Thick- ness Feet	Depth Feet
Cecil Seals (Name) Curtis, Miss. (Address)	surface sand & clay		0
(2) Location: SW 1/4, SE 1/4, Sec. 15, T. 75, R. 6E 2 miles N of Curtis (distance) (direction) (Nearest Town)	to Blue water		200
(3) Topography: Flat (Hilly) (Flat) (Level)	to sand		340
(4) Purpose of Well: Domestic (Domestic Irrigation Municipal, Industrial, Other)	to Bottom		480

Information upon completion of well:

- (1) Diameter: 4 inches.
- (2) Total Depth: 480 feet.
- (3) Water Level: 90 feet below top of ground.
- (4) Cased to 210', Size 4"
- (5) Screen: Size _____, Length _____
- (6) Were any formations sealed against pollution?
 yes, no.

If YES depth of formation 200
Why surface & sand
Drillers Remarks: for chicken
house
24/6/63

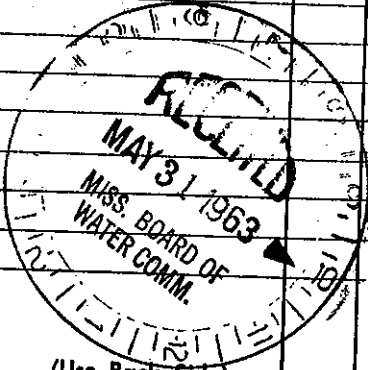

Well No.

Mail this copy to Board of Water Commissioners 429 Miss. St. Jackson, Miss!