

MISSISSIPPI BOARD OF WATER COMMISSIONERS

**WATER WELL DRILLERS LOG**  
**HERNDON WELL & SUPPLY CO.**

**LEE**  
**B 38**  
**2-13-63**

Date: Feb 13, 1963, Driller: P. O. BOX 42 County Lee  
SHANNON, MISSISSIPPI  
(Name)

**Contractor**  
 (1) Owner of Land: William J. Holt  
(Name)  
Canton, Miss.  
(Address)  
 (2) Location: 1/4, 1/4, Sec. 27 T. 75 R. 6E  
1 miles — of Canton  
(distance) (direction) (Nearest Town)  
 (3) Topography: Flat  
(Hilly) (Flat) (Level)  
 (4) Purpose of Well: Domestic  
(Domestic Irrigation) (Municipal, Industrial, Other)


Description & Color of Materials Sand, Clay, Red Clay, Shell, etc.	Thick- ness Feet	Depth Feet
<u>surface sand &amp; clay</u>		<u>0</u>
<u>Blue sand</u>		<u>17</u>
<u>sand &amp; clay</u>		<u>80</u>
<u>Bottom</u>		<u>200</u>

Information upon completion of well:

(1) Diameter 4 inches.  
 (2) Total Depth 200 feet.  
 (3) Water Level 80 feet below top of ground.  
 (4) Cased to 19' 6", Size 4"  
 (5) Screen: Size —, Length —  
 (6) Were any formations sealed against pollution?  
 yes,  no.

If YES depth of formation 17 ft.  
 Why surface & sand

Drillers Remarks:  
25' FLEV 400

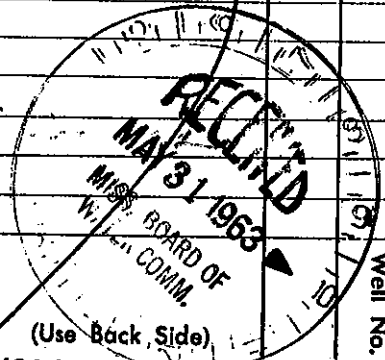

Mail this copy to Board of Water Commissioners 429 Miss. St. Jackson, Miss.