

LEE

MISSISSIPPI BOARD OF WATER COMMISSIONERS

B 39
2-20-63

WATER WELL DRILLERS LOG

HERNDON WELL & SIGHTY CO

Date: Feb 20, 1963, Driller: P. O. BOX
GANTON, MISSISSIPPI County: Lee

(1) Owner of Land: <i>Contract</i> William J. Hall (Name)	Description & Color of Materials Sand, Clay, Red Clay, Shell, etc.	Thick- ness Foot	Depth Foot
<i>Ganton, Miss</i> (Address)	<i>surface sand & clay</i>		0
(2) Location: $\frac{1}{4}$, $\frac{1}{4}$, Sec 27 T. 75 R. 6 E miles (distance) of <i>Ganton</i> (Nearest Town)	<i>Blue sand & sand</i>		215 340
(3) Topography: <i>Flat</i> (Hilly) (Flat) (Level)	<i>Bottom</i>		480
(4) Purpose of Well: <i>Domestic</i> (Domestic Irrigation, Municipal, Industrial, Other)			

Information upon completion of well:


- (1) Diameter 4 inches.
- (2) Total Depth 480 feet.
- (3) Water Level 80 feet below top of ground.
- (4) Cased to 219' Size 4"
- (5) Screen: Size 5, Length
- (6) Were any formations sealed against pollution?
 yes, no.

If YES depth of formation 215'

Why surface sand

Drillers Remarks: 1st haul on right south of business district

46 ELEV 380 (Use Back Side)

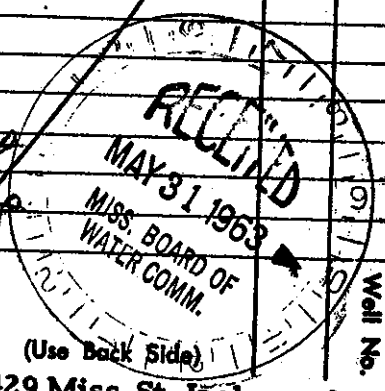

Well No.

Send this copy to Board of Water Commissioners 429 Miss. St. Jackson, Miss.