

LEE
B40
3-8-63

MISSISSIPPI BOARD OF WATER COMMISSIONERS

WATER WELL DRILLERS LOG


Date: April 6, 1963, Driller: HERNDON WELL & SUPPLY CO. County LEE
 P. O. BOX 42
 SHANNON, MISSISSIPPI

(1) Owner of Land:	Description & Color of Materials Sand, Clay, Red Clay, Shell, etc.	Thick- ness Feet	Depth Feet
Contractor <u>William S. Hall</u> (Name) <u>Billy Rice</u> <u>Courtland, Miss</u> (Address)	<u>surface</u>		<u>0</u>
(2) Location: <u>1/4</u> , <u>1/4</u> , Sec <u>28</u> , T. <u>25</u> , R. <u>6</u> <u>1</u> miles (distance), of <u>Courtland</u> (Nearest Town) (direction)	<u>to</u> <u>blue sand</u>		<u>15</u>
(3) Topography: <u>flat</u> (Hilly) (Flat) (Level)	<u>sand</u>		<u>80</u>
(4) Purpose of Well: <u>Domestic</u> (Domestic Irrigation Municipal, Industrial, Other)	<u>then into</u>		<u>210</u>

Information upon completion of well:

- (1) Diameter 4 inches.
- (2) Total Depth 480 feet.
- (3) Water Level 84 feet below top of ground.
- (4) Cased to 219, Size 4"
- (5) Screen: Size _____, Length _____
- (6) Were any formations sealed against pollution?
 yes, no.

<u>brk</u>	<u>360</u>
<u>bottom</u>	<u>480</u>

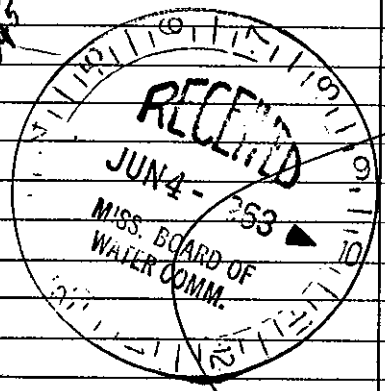

If YES depth of formation 210 ft
 Why surface & sand
 Drillers Remarks: new brick house
on N of road

Hall lines in front

27 ? ELEV 405

(Use Back Side)

Well No.

Mail this copy to Board of Water Commissioners 429 Miss. St. Jackson, Miss.