

MISSISSIPPI BOARD OF WATER COMMISSIONERS

WATER WELL DRILLERS LOG

41
75-63

Driller: HERNDON WELL & SUPPLY CO.
P.O. BOX 42
SHANNON, MISSISSIPPI
County Lee

Owner of Land: Leil Gray
(Name)
Courtown, Miss
(Address)
Location: $\frac{1}{4}$, $\frac{1}{4}$, Sec 15 T 75 R 6E
2 miles N of Courtown
(distance) (direction) (Nearest Town)
Topography: Flat
(Hilly) (Flat) (Level)
Purpose of Well: Domestic
(Domestic Irrigation, Municipal, Industrial, Other)

Description & Color of Materials Sand, Clay, Red Clay, Shell, etc.	Thick- ness Feet	Depth Feet
<u>surface sand</u>	<u>5</u>	<u>0</u>
<u>clay</u>	<u>5</u>	<u>5</u>
<u>blue sand</u>	<u>5</u>	<u>20</u>
<u>sand</u>	<u>5</u>	<u>100</u>
<u>blue sand</u>	<u>5</u>	<u>200</u>
<u>sand</u>	<u>5</u>	<u>320</u>
<u>blue sand</u>	<u>5</u>	<u>460</u>

Information upon completion of well:


- Diameter 4 inches.
- Total Depth 460 feet.
- Water Level 40 feet below top of ground.
- Cased to 209'7", Size 4"
- Screen: Size _____, Length _____

(6) Were any formations sealed against pollution?
 yes, _____ no.

If YES depth of formation 200'

Why surface sand

Drillers Remarks: oldest well
is next to curve

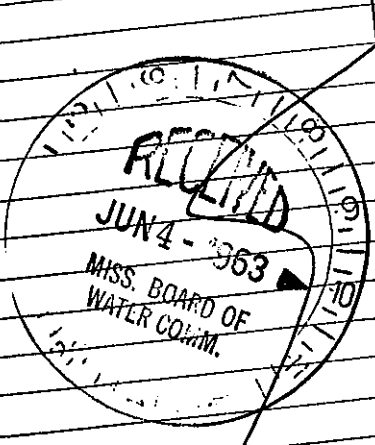

(28) BLEU 395

Well No.

(Use Back Side)

Mail this copy to Board of Water Commissioners 429 Miss. St. Jackson, Miss