

CODED

Lee
B45
11-65

MISSISSIPPI BOARD OF WATER COMMISSIONERS

WATER WELL DRILLERS LOG


Date: Nov 5, 1965 Driller: Herndon-Roman Well & Supply, Inc. County: Lee
(When well drilled) P. O. Box 22 (Where well is located)
SHANNON, MISSISSIPPI 38888

(1) Owner of Land: Cecil Sealey
(Name)
Easton, Miss
(Address)
(2) Location: SE 1/4, SE 1/4, Sec. 15, T. 10 R. 10 E.
1 miles N of Easton
(distance) (direction) (Nearest Town)
(3) Topography: rolling
(Hilly) (Flat) (Level)
(4) Purpose of Well: HOE FARM
(Domestic Irrigation
Municipal, Industrial, Other)

| Description & Color of Materials Sand, Clay, Red Clay, Shell, etc. | Thick- ness Feet | Depth Feet |
|---|------------------------|---------------|
| <u>surface sand & clay</u> | <u>20</u> | <u>20</u> |
| <u>blue clay</u> | <u>60</u> | <u>80</u> |
| <u>sand</u> | <u>95</u> | <u>175</u> |
| <u>blue clay</u> | <u>185</u> | <u>360</u> |
| <u>sand</u> | <u>120</u> | <u>480</u> |
| <u>Bottom</u> | | <u>480</u> |

Information upon completion of well:
(1) Diameter 4 inches.
(2) Total Depth 480 feet.
(3) Water Level 76' feet below top of ground.
(4) Cased to 218', Size 4"
231', Size 2"
(5) Screen: Size 2", Length 40'
(6) Were any formations sealed against pollution?
✓ yes, _____ no.

If YES depth of formation _____
Why surface sand
Drillers Remarks: _____
Yield in gpm: 30
Size pump: 3 HP
Type power: electric

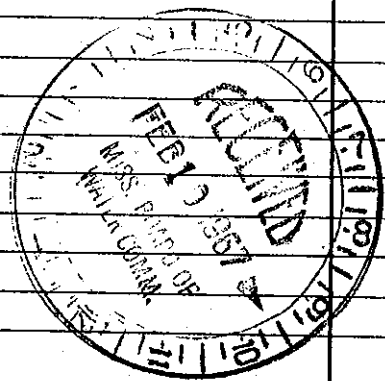

Mail this copy to Board of Water Commissioners 429 Miss. St. Jackson, Miss.

362