

CODED

Lee
B46
12-66

MISSISSIPPI
BOARD OF WATER COMMISSIONERS
416 North State Street
Jackson, Mississippi 39201

WATER WELL DRILLERS LOG

Dec 3, 66 1966 date well completed
Bonds Plumbing + Drilling Co. firm name
Lee county well located

LANDOWNER: R. L. Crable
Renz, Miss.
Rt. 1
(mailing address)


description of formations encountered	from	to
Red + yellow sand	0'	40'
Sandy Blue	40'	120'
Water Sand	120'	170'

WELL LOCATION:
sec. 12 T-7 N R-6 E
1 1/2 miles S.E. of Baldwyn
(distance) (direction) (nearest town)

WELL PURPOSE: Home
(home, irrigation, municipal, industrial)

WELL COMPLETION DATA:

- (1) diameter (inches) 4"
- (2) total depth (feet) 170'
- (3) static water level (feet) 70' below top of ground.
- (4) casing Bl Steel 4.2' (material) (depth)
none (size) if telescope see back.
- (5) screen none (length) (depth to top)
(size) (material)
- (6) pump none (yield gpm)
(type power)
- (7) electric log no (yes or no)
(organization running log)
- (8) how well bottom plugged open

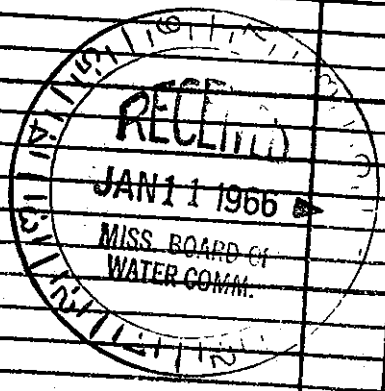

DRILLERS REMARKS:
366