

LEE
B 47
7-2-60

MISSISSIPPI BOARD OF WATER COMMISSIONERS

WATER WELL DRILLERS LOG

B300

Date: July 2, 1960, Driller: SHANNON, MISS. County Lee
(Name)

	Description & Color of Materials Sand, Clay, Red Clay, Shell, etc.	Thick- ness Feet	Depth Feet
(1) Owner of Land: <u>Earl Adams</u> (Name) <u>Baldwyn, Miss.</u> (Address)	<u>Sand & Clay</u>		<u>168</u>
(2) Location: <u>1/4, NE 1/4, Sec. 13 T. 7 R. 6</u> <u>4</u> miles <u>SW</u> of <u>Baldwyn</u> (distance) (direction) (Nearest Town)	<u>Blue Rock</u>		<u>168</u>
(3) Topography: <u>FLAT</u> (Hilly) (Flat) (Level)	<u>Sand</u>		<u>220</u>
(4) Purpose of Well: <u>Home Use</u> (Domestic Irrigation Municipal, Industrial, Other)	<u>Bottom</u>		<u>346</u>


Information upon completion of well:

- (1) Diameter 4 inches.
- (2) Total Depth 346 feet.
- (3) Water Level 65 feet below top of ground.
- (4) Cased to 168 ft, Size 4"
- (5) Screen: Size —, Length —
- (6) Were any formations sealed against pollution?
X yes, — no.

If YES depth of formation 168 ft

Why Surface

Drillers Remarks: ?

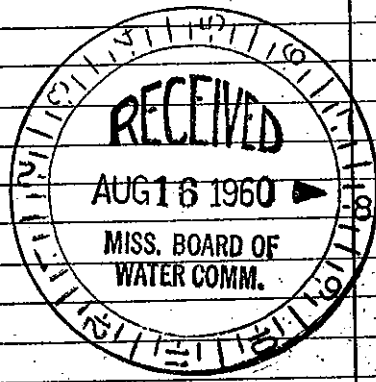

Well No. B300

(Use Back Side)

Mail this copy to Board of Water Commissioners 429 Miss. St. Jackson, Miss