

Lee
548
10-66

CODED

MISSISSIPPI BOARD OF WATER COMMISSIONERS

WATER WELL DRILLERS LOG

Date: Oct. 7, 1966, Driller: Herndon-Homan Well & Supply, Inc.
(When well drilled) P. O. Box 42 County Lee
SHANNON, MISSISSIPPI 38868 (Where well is located)

(1) Owner of Land: Freddie White
(Name) Baldwin, Miss.
(Address)

(2) Location: SE 1/4, SE 1/4, Sec. 10 T7S R1E
(distance) 1 1/2 miles South of Baldwin
(direction) (Nearest Town)

(3) Topography: Flat
(Hilly) (Flat) (Level)

(4) Purpose of Well: Domestic
(Domestic Irrigation
Municipal, Industrial, Other)


Description & Color of Materials Sand, Clay, Red Clay, Shell, etc.	Thick- ness Feet	Depth Feet
<u>surface sand & clay</u>	<u>36</u>	<u>36</u>
<u>blue clay</u>	<u>224</u>	<u>260</u>
<u>sand</u>	<u>120</u>	<u>380</u>

Information upon completion of well:

- (1) Diameter 4 inches.
- (2) Total Depth 380 feet.
- (3) Water Level 60 feet below top of ground.
- (4) Cased to 40', Size 4"
- (5) Screen: Size none, Length _____
- (6) Were any formations sealed against pollution?
 yes, no.

YES depth of formation 36'
by surface & sand

Drillers Remarks:
Yield in gpm: 4
Size pump: 3/4
Type power: Electric

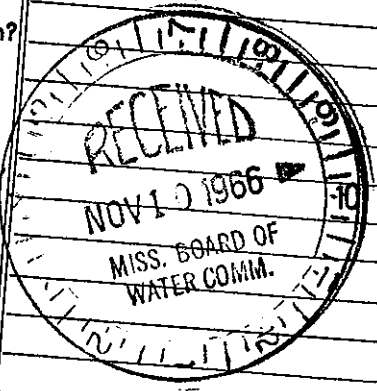

Send this copy to Board of Water Commissioners 429 Miss. St. Jackson, Miss.
365