

LEE
B 67
12-7-73

MISSISSIPPI
BOARD OF WATER COMMISSIONERS
416 North State Street
Jackson, Mississippi 39201

CODED

WATER WELL DRILLERS LOG

12-7-1973 date well completed
Bonds Well Drilling firm name
Lee county well located


LANDOWNER: <u>Bobby Nichols</u> <u>Baldwyn, Miss.</u> (mailing address)	description of formations encountered	from to	
	Red clay	0	16
	Blue clay	16	146
	Water sand	146	170

WELL LOCATION:
sec 12 T 7 N R 6 E
4 miles E of Baldwyn
(distance) (direction) (nearest town)

WELL PURPOSE: Home
(home, irrigation, municipal, industrial)

- WELL COMPLETION DATA:
- (1) diameter (inches) 4"
 - (2) total depth (feet) 170'
 - (3) static water level (feet) 40 ^{below} ~~above~~ top of ground.
 - (4) casing Steel, 21'
(material) (depth)
 if telescope see back.
(size)
 - (5) screen None
(length) (depth to top)
 (size) (material)
 - (6) pump Hand pump
(HP) (yield gpm)
 (type power)
 - (7) electric log no
(yes or no)
 (organization running log)
 - (8) how well bottom plugged open

CODED

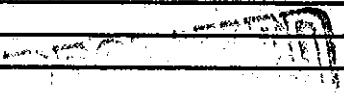

DRILLERS REMARKS:

MISS. BD. OF WATER COMM