

MISSISSIPPI BOARD OF WATER COMMISSIONERS

WATER WELL DRILLERS LOG

Date: 7/14, 1966, Driller: Livingston County Lee
(Name)

(1) Owner of Land: George Scott
(Name)
Baldwyn Rt 1
(Address)

(2) Location: 1/4, 1/4, Sec. 4 T23R2E
6 miles NW of Baldwyn
(distance) (direction) (Nearest Town)

(3) Topography: Hilly
(Hilly) (Flat) (Level)

(4) Purpose of Well: Domestic
(Domestic Irrigation Municipal, Industrial, Other)

Description & Color of Materials Sand, Clay, Red Clay, Shell, etc.	Thick- ness Feet	Depth Feet
<u>Joint Clay</u>	<u>0</u>	<u>30</u>
<u>Blue Clay</u>	<u>30</u>	<u>225</u>
<u>Sand</u>	<u>225</u>	<u>391</u>


Information upon completion of well:

- (1) Diameter 4 inches.
- (2) Total Depth 391 feet.
- (3) Water Level 80 feet below top of ground.
- (4) Cased to 35 ft. Size 4 in.
- (5) Screen: Size _____, Length _____.
- (6) Were any formations sealed against pollution?
 yes, no.

If YES depth of formation _____

Why _____

Drillers Remarks: _____

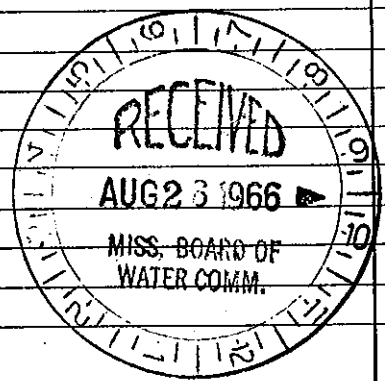

(Use Back Side)

Well No.