

See
B 200
7-66

MISSISSIPPI BOARD OF WATER COMMISSIONERS

WATER WELL DRILLERS LOG

Date: 7/30, 1966, Driller: F. W. Jones County: See
(Name)

(1) Owner of Land: D. Wayne Ellison
(Name)
Benton
(Address)

(2) Location: 1/4, 1/4, Sec. 30, T. 8 R. 10 E.
3.14 miles SW of Benton
(distance) (direction) (Nearest Town)

(3) Topography: Hilly
(Hilly) (Flat) (Level)

(4) Purpose of Well: Domestic
(Domestic Irrigation
Municipal, Industrial, Other)


Description & Color of Materials Sand, Clay, Red Clay, Shell, etc.	Thick- ness Feet	Depth Feet
<u>hard clay</u>	<u>0</u>	<u>25</u>
<u>Blue clay</u>	<u>25</u>	<u>100</u>
<u>Sand</u>	<u>100</u>	<u>218</u>

Information upon completion of well:

- (1) Diameter 3 1/8 inches.
- (2) Total Depth 218 feet.
- (3) Water Level _____ feet below top of ground.
- (4) Cased to 27 ft below 4 in, Size _____
- (5) Screen: Size _____, Length _____
- (6) Were any formations sealed against pollution?
_____ yes, _____ no.

If YES depth of formation _____
Why _____

Drillers Remarks: _____

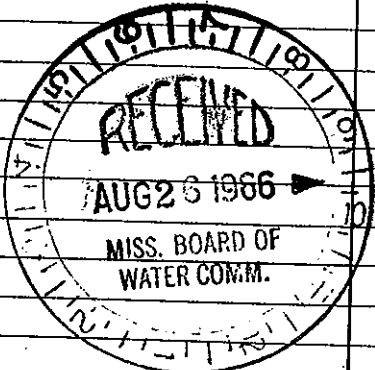

Well No.

(Use Back Side)