

Lee
B 2007
8-66

MISSISSIPPI BOARD OF WATER COMMISSIONERS

WATER WELL DRILLERS LOG

Date: Aug 17, 1966, Driller: D. C. Webb, Jr., County Lee

(Name)

(1) Owner of Land: S. R. Agnew
(Name)
BRICES CROSS ROADS
(Address)

(2) Location: 1/4, 1/4, Sec. 1 T75R6E
5 miles W. of FALDWIN
(distance) (direction) (Nearest Town)

(3) Topography: HILLY
(Hilly) (Flat) (Level)

(4) Purpose of Well: DOMESTIC
(Domestic Irrigation
Municipal, Industrial, Other)

Description & Color of Materials Sand, Clay, Red Clay, Shell, etc.	Thick- ness Feet	Depth Feet
<u>Brown Clay Sand</u>	<u>0</u>	<u>20</u>
<u>Blue MARL</u>	<u>20</u>	<u>100</u>
<u>Blue SAND & MARL</u>	<u>100</u>	<u>280</u>
<u>Blue MARL</u>	<u>280</u>	<u>295</u>
<u>" "</u>	<u>295</u>	<u>340</u>
<u>Blue SAND MIXED</u>	<u>340</u>	<u>620</u>
<u>with blue MARL</u>		<u>550</u>
<u>Blue SAND</u>	<u>550</u>	<u>620</u>

Information upon completion of well:

(1) Diameter 4 inches.

(2) Total Depth 620 feet.

(3) Water Level 90' feet below top of ground.

(4) Cased to 295, Size 4"


(5) Screen: Size _____, Length _____

(6) Were any formations sealed against pollution?
_____ yes, _____ no.

If YES depth of formation _____

Why _____

Drillers Remarks: _____

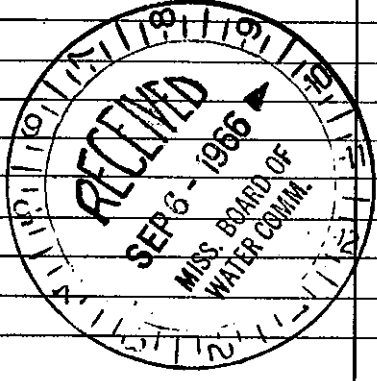

Well No.

(Use Back Side)

Mail this copy to Board of Water Commissioners 429 Miss. St. Jackson, Mis: