

C 15

WATER WELL DRILLERS LOG

8-18-60

Date: Aug 18 1960, Driller: O. C. Webb County Lee
(Name)

	Description & Color of Materials Sand, Clay, Red Clay, Shell, etc	Thick- ness Feet	Depth Feet
(1) Owner of Land: <u>Rivers Martin</u> <small>(Name)</small>	<u>soil to 30 ft</u>		
<u>Buntown Miss</u> <small>(Address)</small>	<u>sand to 150</u>		
(2) Location: <u>JW 1/4, SW 1/4, Sec. 29 T7R7</u> <small>(distance) (direction) (Nearest Town)</small>	<u>27 Blue Rock</u>		
<u>5 miles East Buntown</u> <small>(distance) (direction) (Nearest Town)</small>	<u>to 280 ft water</u>		
(3) Topography: <input checked="" type="checkbox"/> <u>Hilly</u> <small>(Hilly) (Flat) (Level)</small>	<u>sand to 400 ft</u>		
(4) Purpose of Well: <input checked="" type="checkbox"/> <u>Domestic Irrigation</u> <small>(Domestic Irrigation Municipal, Industrial, Other)</small>			


Information upon completion of well:

- (1) Diameter 4 inches.
- (2) Total Depth 400 feet.
- (3) Water Level 135 feet below top of ground.
- (4) Cased to 154 ft, Size 4 in.
- (5) Screen: Size 0, Length 0.
- (6) Were any formations sealed against pollution?
 yes, no.

If YES depth of formation _____

Why _____

Drillers Remarks: white house
well near ditch
30 ELEV 440

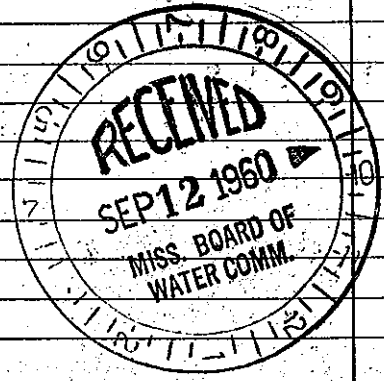

(Use Back Side)

Well No. C 300

Retain this copy for your office files.