

LEE

MISSISSIPPI BOARD



C 16
5-21-62

WATER WELL DRILLERS LOG

Date: 5-21, 1962, Driller: C. C. Wehler County Lee

(Name)

	Description & Color of Materials Sand, Clay, Red Clay, Shell, etc.	Thick- ness Feet	Depth Feet
(1) Owner of Land: Donald Bryan (Name)	soil 4 ft sand		
Baldwyn Miss (Address)	4 clay to 153 ft		
(2) Location: NW 1/4, NE 1/4, Sec. 32 T2R7, SE	Blue muck to		
7 miles East of Hunttown (distance) (direction) (Nearest Town)	2.85 ft water		
(3) Topography: <input checked="" type="checkbox"/> (Hilly) <input type="checkbox"/> (Flat) <input type="checkbox"/> (Level)	Sand to 400 ft		
(4) Purpose of Well: <input checked="" type="checkbox"/> (Domestic Irrigation) <input type="checkbox"/> (Municipal, Industrial, Other)	Water Sand		
Information upon completion of well:			
(1) Diameter 4 inches.			
(2) Total Depth 400 feet.			
(3) Water Level 160 feet below top of ground.			
(4) Cased to 165 ft, Size 4"			
(5) Screen: Size 0, Length 6			
(6) Were any formations sealed against pollution?			
_____ yes, 0 no.			
If YES depth of formation _____			
Why _____			
Drillers Remarks: Beauty shop			
33 ELEV 460			

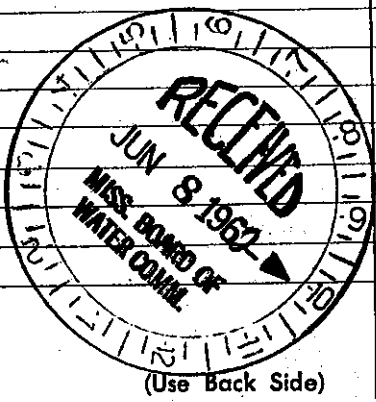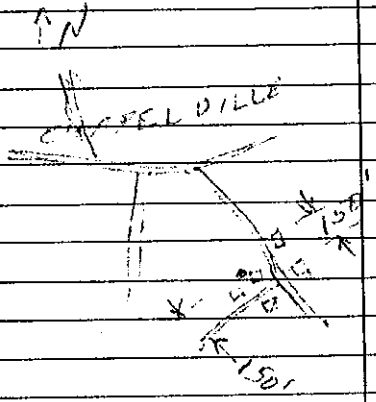

Well No.

Mail this copy to Board of Water Commissioners 429 Miss. St. Jackson, Miss