

LEE

MISSISSIPPI BOARD OF WATER COMMISSIONERS

C17
6-29-63

WATER WELL DRILLERS LOG

HERNDON WELL & SUPPLY CO.

Date: 6-29, 1963, Driller: P. O. BOX 12 County Lee

SHANNON (Name) MISSISSIPPI

(1) Owner of Land: <u>Lawrence & Mary Ann</u> (Name)	Description & Color of Materials Sand, Clay, Red Clay, Shell, etc.	Thick- ness Feet	Depth Feet
<u>At Guatemala, Miss.</u> (Address)	<u>surface sand</u>		<u>0</u>
(2) Location: <u>NE 1/4, NW 1/4, Sec 17 T 75 R 7E</u> <u>4</u> miles <u>SE</u> of <u>Ballinger</u> (distance) (direction) (Nearest Town)	<u>clay</u> <u>Blowback</u>	<u>8</u>	<u>178</u>
(3) Topography: <u>Hilly</u> (Hilly) (Flat) (Level)	<u>sand</u>		<u>290</u>
(4) Purpose of Well: <u>Domestic</u> (Domestic Irrigation Municipal, Industrial, Other)	<u>8</u>		

Bottom 400

Information upon completion of well:

- (1) Diameter 4 inches.
- (2) Total Depth 400 feet.
- (3) Water Level 170 feet below top of ground.
- (4) Cased to 181', Size 4".
- (5) Screen: Size , Length .
- (6) Were any formations sealed against pollution?
 yes, no.


If YES depth of formation 178'

Why Surface & sand

Drillers Remarks:

white house

39 ELEV 440

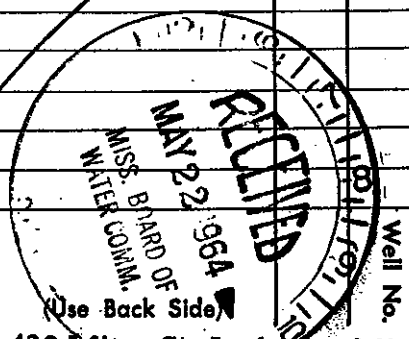

Well No.

Mail this copy to Board of Water Commissioners 429 Miss. St. Jackson, Miss.