

Lee
C20
7-66

CODED

MISSISSIPPI BOARD OF WATER COMMISSIONERS

WATER WELL DRILLERS LOG

Herndon-Homan Well & Supply, Inc.

P. O. Box 42

Date: July 7, 1966, Driller: SHANNON, MISSISSIPPI County Lee
(When well drilled) (Name) (Where well is located)

	Description & Color of Materials Sand, Clay, Red Clay, Shell, etc.	Thick- ness Feet	Depth Feet
(1) Owner of Land: <u>Benny Hill</u> (Name) <u>At Baldwyn, Miss.</u> (Address)	<u>surface sand</u>		
(2) Location: <u>NE 1/4, SE 1/4, Sec. 10 T19R7E</u> <u>5 miles SE</u> of <u>Baldwyn</u> (distance) (direction) (Nearest Town)	<u>+ clay</u> <u>blue clay</u> <u>red clay</u> <u>bottom</u>	<u>0-38</u> <u>38-140</u> <u>140-260</u> <u>260</u>	
(3) Topography: <u>flat</u> (Hilly) (Flat) (Level)			
(4) Purpose of Well: <u>Domestic</u> (Domestic Irrigation Municipal, Industrial, Other)			

Information upon completion of well:

- (1) Diameter 4 inches.
- (2) Total Depth 260 feet.
- (3) Water Level 60 feet below top of ground.
- (4) Cased to 41' 6", Size 5"
- (5) Screen: Size none, Length -
- (6) Were any formations sealed against pollution?
 yes, no.

If YES depth of formation 36'


Why surface sand

Drillers Remarks: no pump installed

Yield in gpm: _____

Size pump: _____

Type power: _____

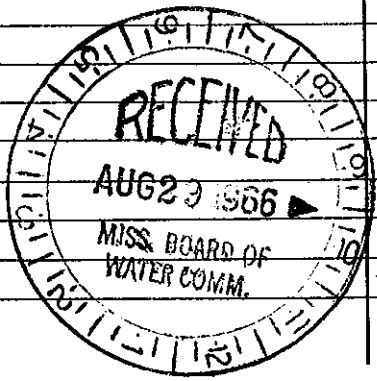

Mail this copy to Board of Water Commissioners 429 Miss. St. Jackson, Miss.