

Lee  
C21  
6-67

CODED

MISSISSIPPI BOARD OF WATER COMMISSIONERS

WATER WELL DRILLERS LOG

Herndon-Homan Well & Supply, Inc.

Date: 6-15, 1967, Driller: SHANNON, P. O. Box 42, County Lee  
(When well drilled) (Where well is located)


(1) Owner of Land: Elmer Johnson  
(Name)  
Baldwin, Miss  
(Address)  
(2) Location: SW 1/4, NW 1/4, Sec. 9 T5R5E  
5 miles SE of Baldwin  
(distance) (direction) (Nearest Town)  
(3) Topography: flat  
(Hilly) (Flat) (Level)  
(4) Purpose of Well: Home  
(Domestic Irrigation) (Municipal, Industrial, Other)

Description & Color of Materials Sand, Clay, Red Clay, Shell, etc.	Thick- ness Feet	Depth Feet
<u>surface sand</u>		
<u>+ clay</u>		<u>0-35</u>
<u>blue clay</u>		<u>35-120</u>
<u>sand</u>		<u>120-240</u>
<u>bottom</u>		<u>240</u>

Information upon completion of well:

(1) Diameter 4 inches.  
(2) Total Depth 240 feet.  
(3) Water Level 50 feet below top of ground.  
(4) Cased to 37'10", Size 4"  
(5) Screen: Size none, Length \_\_\_\_\_  
(6) Were any formations sealed against pollution?  
✓ yes, \_\_\_\_\_ no.

If YES depth of formation 35'  
Why surface & sand  
Drillers Remarks: \_\_\_\_\_  
Yield in gpm: \_\_\_\_\_  
Size pump: by other  
Type power: \_\_\_\_\_

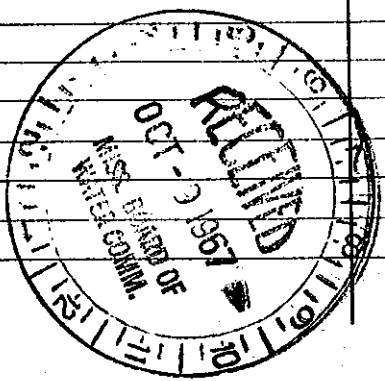

Retain this copy for your office files.