

LEE
C49
5-20-74

MISSISSIPPI
BOARD OF WATER COMMISSIONERS
416 North State Street
Jackson, Mississippi 39201

CODED

WATER WELL DRILLERS LOG

5-20 1974 Bonds Well Drilling Lee
date well completed firm name county well located


LANDOWNER: <u>Gary Edge</u>	description of formations encountered	from	to
<u>Baldwin, Miss.</u> (mailing address)			
	<u>Red clay</u>	<u>0</u>	<u>35</u>
	<u>Blue clay</u>	<u>35</u>	<u>210</u>
	<u>Water sand</u>	<u>210</u>	<u>250</u>

WELL LOCATION:
sec 9 T 7 N R 7 E
3 miles East of Baldwin
(distance) (direction) (nearest town)

CODED

WELL PURPOSE: Home
(home, irrigation, municipal, industrial)

- WELL COMPLETION DATA:
- (1) diameter (inches) 4"
 - (2) total depth (feet) 250
 - (3) static water level (feet) 55 ^{below} _{above} top of ground.
 - (4) casing Steel 42
(material) (depth)
(size) If telescope see back.
 - (5) screen None
(length) (depth to top)
(size) (material)
 - (6) pump hand
(HP) (yield gpm)
(type power)
 - (7) electric log no
(yes or no)
(organization running log)
 - (8) how well bottom plugged open

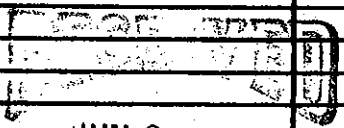

JUN 26 1974

DRILLERS REMARKS: _____
MISS. BD. OF WATER COMM.