

MISSISSIPPI BOARD OF WATER COMMISSIONERS

WATER WELL DRILLERS LOG


Date: 8/17, 1966, Driller: G Wingbeam, County See
(Name)

(1) Owner of Land:	Description & Color of Materials Sand, Clay, Red Clay, Shell, etc.	Thick- ness Feet	Depth Feet
<u>5 Springs Hill B Church</u> <small>(Name)</small>	<u>Dark Clay</u>	<u>0</u>	<u>30</u>
<u>Baldwyn</u> <small>(Address)</small>	<u>Blue Clay</u>	<u>30</u>	<u>250</u>
<u>6 T 7 R E</u>	<u>Sand</u>	<u>250</u>	<u>326</u>
(2) Location: <u>1/4</u> , <u>1/4</u> , Sec. <u>6</u> T <u>7</u> R <u>E</u>			
<u>3</u> miles <u>E</u> of <u>Baldwyn</u> <small>(distance) (direction) (Nearest Town)</small>			
(3) Topography: <u>hills</u> <small>(Hilly) (Flat) (Level)</small>			
(4) Purpose of Well: <u>Domestic</u> <small>(Domestic Irrigation Municipal, Industrial, Other)</small>			

Information upon completion of well:

- (1) Diameter 4 inches.
- (2) Total Depth 326 feet.
- (3) Water Level 60 feet below top of ground.
- (4) Cased to 42 ft, Size 4 in.
- (5) Screen: Size _____, Length _____.
- (6) Were any formations sealed against pollution?
 yes, no.

If YES depth of formation _____
 Why _____
 Drillers Remarks: _____

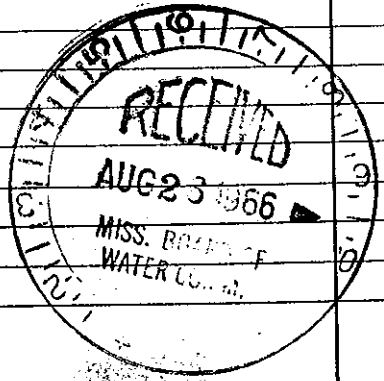

(Use Back Side)

Well No.

Mail this copy to Board of Water Commissioners 429 Miss. St. Jackson, Miss.