

Lee
C7003
7-10-68

MISSISSIPPI
BOARD OF WATER COMMISSIONERS
416 North State Street
Jackson, Mississippi 39201

WATER WELL DRILLERS LOG

July 10 1968 Bonds Lee
date well completed firm name county well located


LANDOWNER: Jae Lura
Baldwyn Miss
Highway 376
(mailing address)

description of formations encountered	from	to
Red clay	0	8
Sand	8	20
Blue Clay	90	145
Wat. Sand	145	200

WELL LOCATION:
sec. 15 T 7 N R 7 E
6 miles East of Baldwyn
(distance) (direction) (nearest town)

WELL PURPOSE: Home
(home, irrigation, municipal, industrial)

- WELL COMPLETION DATA:
- (1) diameter (inches) 4
 - (2) total depth (feet) 200
 - (3) static water level (feet) 60 below top of ground
 - (4) casing Steel 21 (material) (depth)
4" of telescope see back. (size)
 - (5) screen None (length) (depth to top)
None (size) (material)
 - (6) pump None install (yield gpm)
(type power)
 - (7) electric log None (yes or no)
(organization running log)
 - (8) how well bottom plugged Open

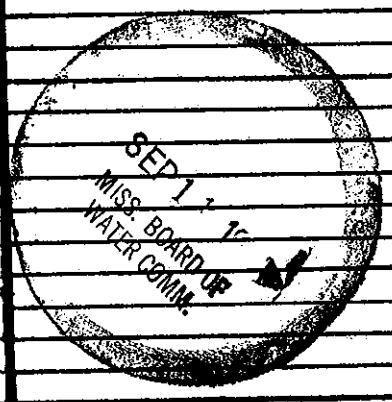

DRILLERS REMARKS: