


WATER WELL DRILLERS LOG

Date: 11-9-60, Driller: Ewing Gas Co. County: Pointe Coupee
(Name)

11-9-60

(1) Owner of Land: <u>S. J. Huey</u> <small>(Name)</small>	Description & Color of Materials Sand, Clay, Red Clay, Shell, etc.	Thick- ness Feet	Depth Feet
<u>At. 1 - Belden, Miss.</u> <small>(Address)</small>		0	40
(2) Location: <u>1/4, SW 1/4, Sec. 21 T. 2 R. 4 E</u>		40	450
<u>1/2</u> miles <u>South</u> of <u>Louisiana</u> <small>(distance) (direction) (Nearest Town)</small>		450	600
(3) Topography: <u>C</u> <small>(Hilly) (Flat) (Level)</small>		600	810
(4) Purpose of Well: <u>Household</u> <small>(Domestic Irrigation, Municipal, Industrial, Other)</small>			

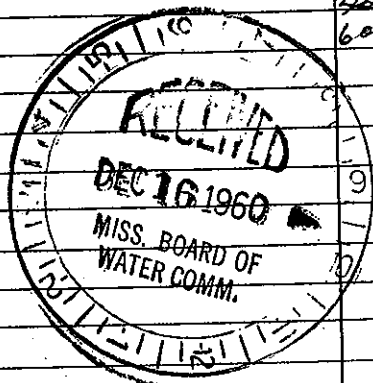

Information upon completion of well:

(1) Diameter: 4 inches.

(2) Total Depth: 810 feet.

(3) Water Level: 180 feet below top of ground.

(4) Cased to: 42', Size _____.

(5) Screen: Size _____, Length _____.

(6) Were any formations sealed against pollution?
 yes, _____ no.

If YES depth of formation: 42'

Why _____

Drillers Remarks: _____

150

(Use Back Side)

Well No.

Mail this copy to Board of Water Commissioners 429 Miss. St. Jackson, Miss