

LEE

MISSISSIPPI BOARD OF WATER COMMISSIONERS

D 17

4-18-63

WATER WELL DRILLERS LOG

Date: 7/16, 1963, Driller: HERNDON WELL & SUPPLY CO. County: Lee

STATE (Name) MISSISSIPPI

(1) Owner of Land:	Description & Color of Materials Sand, Clay, Red Clay, Shell, etc.	Thick- ness Feet	Depth Feet
Herman Irwin (Name) Mt 1 Sattillo, Miss. (Address)	surface sand & clay		0
(2) Location: 1/4, 1/4, Sec 22, T 85E 5 miles W of Sattillo (distance) (direction) (Nearest Town)	Blue water	5	25
(3) Topography: flat (Hilly) (Flat) (Level)	sand		80
(4) Purpose of Well: Domestic (Domestic Irrigation Municipal, Industrial, Other)			



Information upon completion of well:

- (1) Diameter 4 inches.
- (2) Total Depth 200 feet.
43.00 2/15/67
- (3) Water Level 50 feet below top of ground.
- (4) Cased to 30', Size 44
- (5) Screen: Size —, Length —
- (6) Were any formations sealed against pollution?
yes, no.

If YES depth of formation 24'

Why surface & sand

Drillers Remarks:

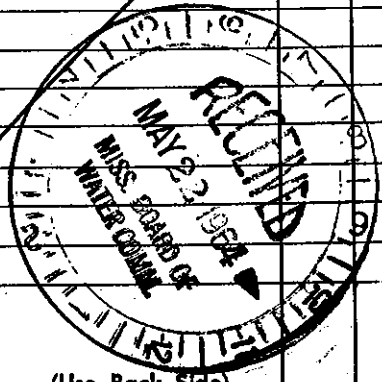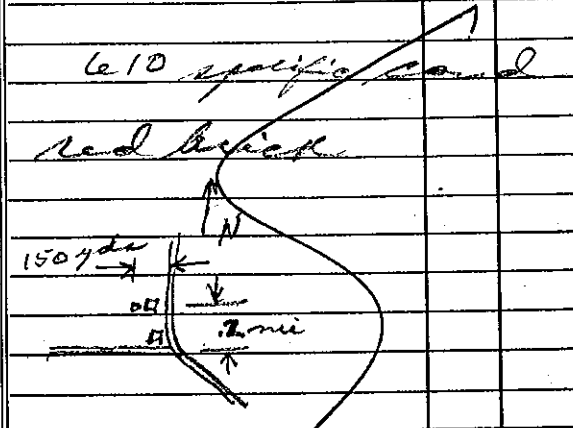

Well No.

(Use Back Side)

Mail this copy to Board of Water Commissioners 429 Miss. St. Jackson, Miss.

50 ELEV 335