

LEE

MISSISSIPPI BOARD OF WATER COMMISSIONERS

D18 CROOM FOSTER (Route)

7-2-63


WATER WELL DRILLERS LOG

130
55.98
74.02

Date: 7/11, 1963, Driller: HERNDON WELL & SUPPLY CO. County: Lee

P.O. BOX 42
SHANNON, MISSISSIPPI

| (1) Owner of Land | Description & Color of Materials Sand, Clay, Red Clay, Shell, etc. | Thick- ness Feet | Depth Feet |
|---|---|------------------------|---------------|
| J.B. Wackenberg (Name) At Gattilla, Miss. (Address) | surface sand & clay | 0 | 0 |
| (2) Location: 1/4, 1/4, Sec 15 T 85 R 5 E 9 miles N W of Gattilla (distance) (direction) (Nearest Town) | Blue sand sand | 38 240 | 38 240 |
| (3) Topography: flat (Hilly) (Flat) (Level) | sand & shell | 340 | 340 |
| (4) Purpose of Well: Domestic (Domestic Irrigation Municipal, industrial, Other) | sand | 470 | 470 |
| Information upon completion of well: (1) Diameter 5 inches. | Bottom | 520 | 520 |
| (2) Total Depth 510 feet. 74.02 2/16/67 | | | |
| (3) Water Level 80 feet below top of ground. | | | |
| (4) Cased to 40', Size 54 | | | |
| (5) Screen: Size —, Length — | | | |
| (6) Were any formations sealed against pollution? yes, no. | | | |
| If YES depth of formation 36' | | | |
| Why surface & ground | | | |
| Drillers Remarks: submersible | | | |

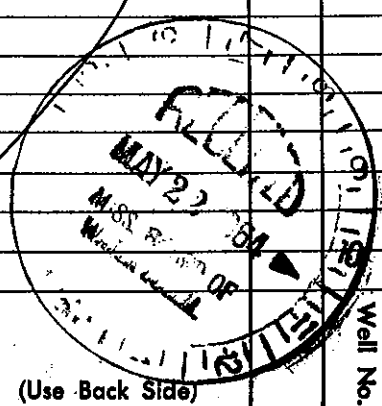

(Use Back Side)

Mail this copy to Board of Water Commissioners 429 Miss. St. Jackson, Miss.