

LEE

MISSISSIPPI BOARD OF WATER COMMISSIONERS

D21
10-1-62

WATER WELL DRILLERS LOG

HERNDON WELL & SUPPLY CO.

Date: 10/1, 1962, Driller: P. O. BOX 42 County: Lee
SHANNON, MISSISSIPPI

	Description & Color of Materials Sand, Clay, Red Clay, Shell, etc.	Thick- ness Feet	Depth Feet
(1) Owner of Land: <u>Rudolph Guarnard</u> (Name) <u>Rt 2 Sattilla, Miss.</u> (Address)	<u>sand & clay</u>		<u>0</u>
(2) Location: <u>22 85</u> <u>SE</u> <u>Blumark</u> <u>4</u> miles <u>W</u> of <u>Sattilla</u> (distance) (direction) (Nearest Town)	<u>sand</u>		<u>25</u> <u>40</u>
(3) Topography: <u>Flat</u> (Hilly) (Flat) (Level)	<u>s</u>		
(4) Purpose of Well: <u>Domestic</u> (Domestic Irrigation Municipal, Industrial, Other)	<u>Bottom</u>		<u>140</u>


Information upon completion of well:

- (1) Diameter 4 inches.
- (2) Total Depth 140 feet.
- (3) Water Level _____ feet below top of ground.
- (4) Cased to 28' 8", Size 4".
- (5) Screen: Size _____, Length _____.
- (6) Were any formations sealed against pollution?
 yes, _____ no.

If YES depth of formation 25'
Why surface & sand

Drillers Remarks: _____
Case measure w.h.

4.7 ELEV 315'

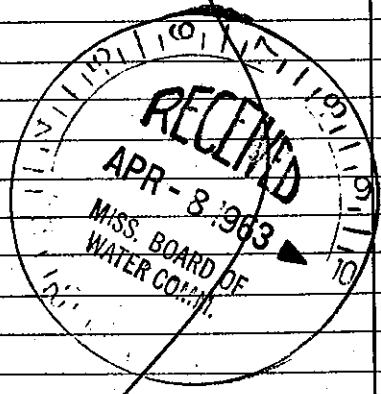

(Use Back Side)

Well No.