


LEE
D23
10-5-62

MISSISSIPPI BOARD OF WATER COMMISSIONERS

WATER WELL DRILLERS LOG

Date: Oct. 5, 1962, Driller: Johnny Welt County LEE

(1) Owner of Land: Cecil Rannell (Name) Sherman, Mississippi (Address)	Description & Color of Materials Sand, Clay, Red Clay, Shell, etc.	Thick- ness Feet	Depth Feet
(2) Location: 1/4, NE 1/4, Sec. 31 T5 R5 E 1 1/2 miles NE of Sherman (distance) (direction) (Nearest Town)	clay	0	13'
(3) Topography: Level (Hilly) (Flat) (Level)	Blue Marl	13'	190'
(4) Purpose of Well: Domestic (Domestic Irrigation Municipal, Industrial, Other)	White Sand	190	310'

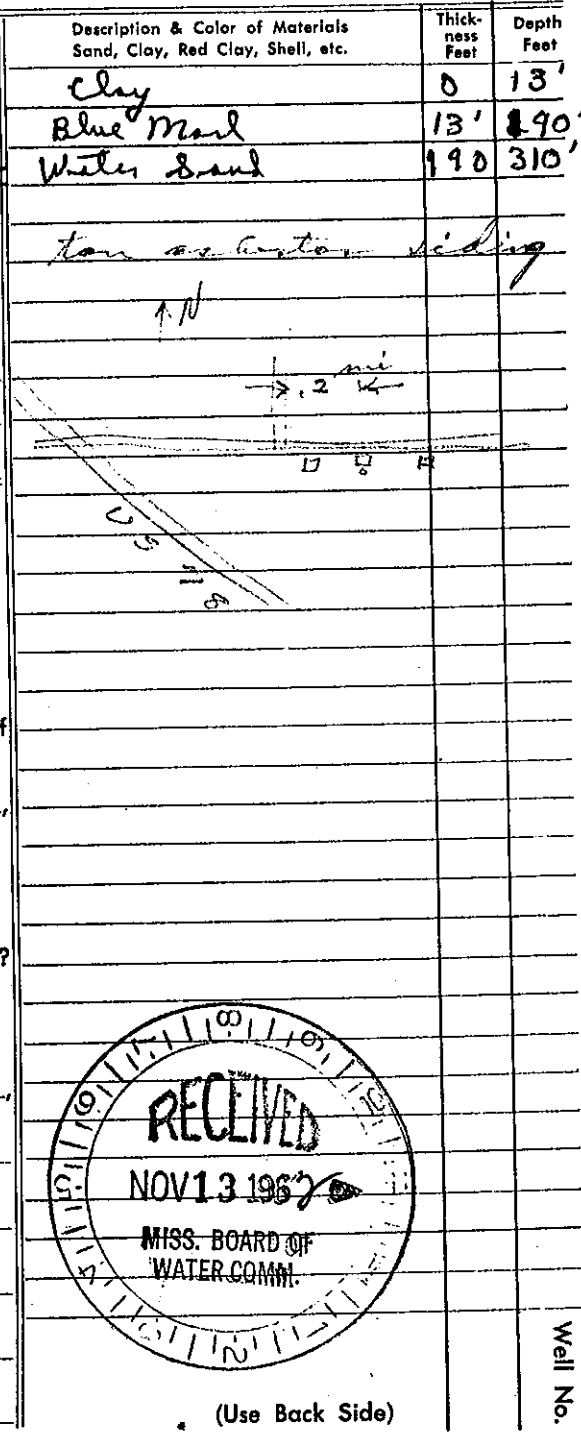

Information upon completion of well:

(1) Diameter 4 inches.

(2) Total Depth 310 feet.

(3) Water Level 80 feet below top of ground.

(4) Cased to 21', Size 4"

(5) Screen: Size _____, Length _____.


(6) Were any formations sealed against pollution?
_____ yes, _____ no.

If YES depth of formation _____

Why _____

Drillers Remarks: _____

48 ELEV 360

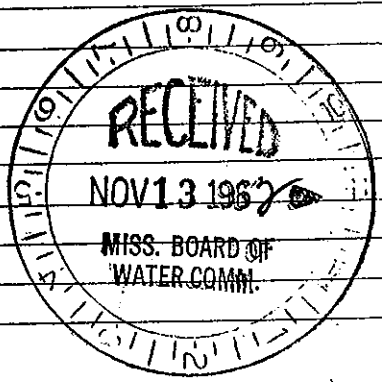

Well No.

(Use Back Side)

Mail this copy to Board of Water Commissioners 429 Miss. St. Jackson, Miss