

**LEE MISSISSIPPI BOARD OF WATER COMMISSIONERS**

**D24 WATER WELL DRILLERS LOG**  
**3-27-65**

Date: April 27, 1965, Driller: Herndon-Homan Well & Supply, Inc. County: Lee  
 P. O. Box 42  
 Name: SHANNON, MISSISSIPPI 38868

		Description & Color of Materials Sand, Clay, Red Clay, Shell, etc.	Thick- ness Feet	Depth Feet
(1) Owner of Land:	<u>Mr. Jim Bucy</u> (Name)			
	<u>At Sallis, Miss.</u> (Address)	<u>sand &amp; clay</u>		<u>0-20</u>
(2) Location:	<u>1/4, 1/4, Sec 26 T 85 R 5E</u>	<u>Blue clay</u>		<u>20-90</u>
	<u>3 miles SW of Sallis</u> (distance) (direction) (Nearest Town)	<u>Sand</u>		<u>90-190</u>
(3) Topography:	<u>Flat</u> (Hilly) (Flat) (Level)	<u>Blue clay</u>		<u>190-339</u>
(4) Purpose of Well:	<u>Domestic</u> (Domestic Irrigation Municipal, Industrial, Other)	<u>Bank</u>		<u>339-340</u>
		<u>Sand</u>		<u>340-460</u>
		<u>Bottom</u>		<u>460</u>

Information upon completion of well:

- (1) Diameter 4 inches.
- (2) Total Depth 460 feet.
- (3) Water Level 80 feet below top of ground.
- (4) Cased to 197', Size 4"
- (5) Screen: Size \_\_\_\_\_, Length \_\_\_\_\_
- (6) Were any formations sealed against pollution?  
 yes,  no.


If YES depth of formation 190'

Why surface sand

Drillers Remarks: \_\_\_\_\_

52 ELEV 320

stain this copy for your office files.

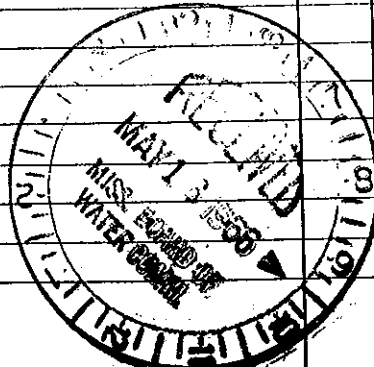

(Use Back Side)

Well No. \_\_\_\_\_