

LEE MISSISSIPPI BOARD OF WATER COMMISSION

D 26
5-29-62 INDEXED

WATER WELL DRILLERS LOG

Date: 5/29, 1962, Driller: James R. Fowler, County: Lee

	Description & Color of Materials Sand, Clay, Red Clay, Shell, etc.	Thick- ness Feet	Depth Feet
(1) Owner of Land: Marion Calmes (Name)			
Gatella RT. 1 (Address)			
(2) Location: 1/4, 1/4, Sec. 3 T. 8 R. 5 E			
5 miles W of SAbtilla (distance) (direction) (Nearest Town)			
(3) Topography: Hilly (Hilly) (Flat) (Level)			
(4) Purpose of Well: DOMESTIC (Domestic Irrigation Municipal, Industrial, Other)			

Information upon completion of well:


- (1) Diameter 4" inches.
- (2) Total Depth 305' feet.
- (3) Water Level 60' feet below top of ground.
- (4) Cased to 21'-8", Size 4"
- (5) Screen: Size _____, Length _____.
- (6) Were any formations sealed against pollution?
_____ yes, _____ no.

If YES depth of formation _____

Why _____

Drillers Remarks: _____

46

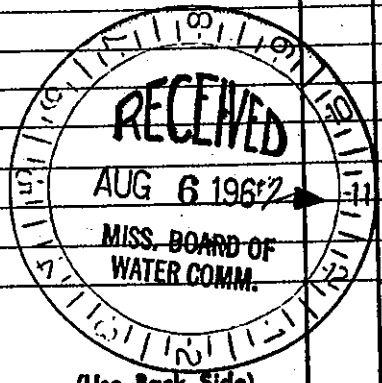

(Use Back Side)

Well No.

Mail this copy to Board of Water Commissioners 429 Miss. St. Jackson, Miss.