

Lee

MISSISSIPPI BOARD OF WATER COMMISSIONERS


D 27  
8-65

CODED

WATER WELL DRILLERS LOG

Date: August, 1965, Driller: Johnny Webb County Pontotoc  
Dillard (Name)

	Description & Color of Materials Sand, Clay, Red Clay, Shell, etc.	Thick- ness Feet	Depth Feet
(1) Owner of Land: <u>Mr. Dillard</u> (Name) <u>Sherman, Miss.</u> (Address)	<u>Clay to 25'</u>		
(2) Location: <u>SE</u> <u>1/4</u> , <u>1/4</u> , Sec. <u>13 T. 8 R. 8 E.</u> <u>4</u> miles <u>N.E.</u> of <u>Sherman</u> (distance) (direction) (Nearest Town)	<u>Blue mud to 250'</u>		
(3) Topography: <u>X</u> (Hilly) (Flat) (Level)	<u>Water sand to 370'</u>		
(4) Purpose of Well: <u>Domestic</u> (Domestic Irrigation Municipal, Industrial, Other)			
Information upon completion of well:			
(1) Diameter <u>4"</u> inches.			
(2) Total Depth <u>370</u> feet.			
(3) Water Level <u>80'</u> feet below top of ground.			
(4) Cased to <u>42'</u> , Size <u>4"</u>			
(5) Screen: Size _____, Length _____			
(6) Were any formations sealed against pollution? _____ yes, _____ no.			
If YES depth of formation _____			
Why _____			
Drillers Remarks: _____			
_____			
_____			
<u>53</u>			

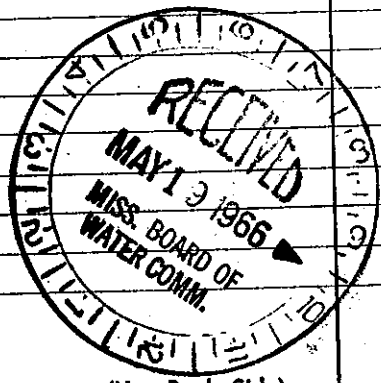

(Use Back Side)

Well No.

Mail this copy to Board of Water Commissioners 429 Miss. St. Jackson. Miss.