

CODED

Lee
D30
10-66

MISSISSIPPI
BOARD OF WATER COMMISSIONERS
416 North State Street
Jackson, Mississippi 39201
WATER WELL DRILLERS LOG

date well completed Oct 6 19 66 Herndon-Homan Well & Supply, Inc. county well located Lee
firm name P. O. Box 42

LANDOWNER: <u>LYMA MARTIN</u>	description of formations encountered	from	to
<u>511 Saffell, Miss.</u>	<u>yellow sand clay</u>	<u>0</u>	<u>20</u>
(mailing address)	<u>Blue clay</u>	<u>20</u>	<u>200</u>
	<u>Sand</u>	<u>200</u>	<u>320</u>
	<u>Bottom</u>	<u>2</u>	<u>320</u>


WELL LOCATION:
sec. 9 T. 8 N. R. 5 E.
S. W.
5 miles NW of Saffell
(distance) (direction) (nearest town)

WELL PURPOSE: Home
(home, irrigation, municipal, industrial)

- WELL COMPLETION DATA:
- (1) diameter (inches) 4"
 - (2) total depth (feet) 320'
 - (3) static water level (feet) 80' below top of ground.
 - (4) casing Steel, 22'
(material) (depth)
 If telescope see back.
(size)
 - (5) screen NONE
(length) (depth to top)

(size) (material)
 - (6) pump 3/4 3
(HP) (yield gpm)
Electric
(type power)
 - (7) electric log NO
(yes or no)

(organization running log)
 - (8) how well bottom plugged open

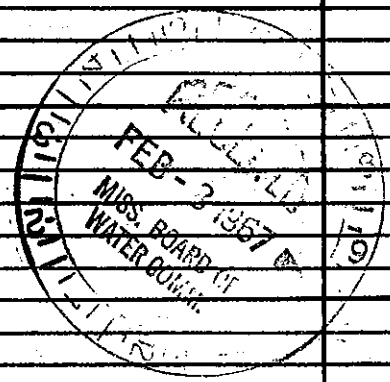

DRILLERS REMARKS:
367