
	State V	Vell Report	r	
County: <u>Lee</u>	I	Part 1	For Office Use Only:	
Permit #:	Mississippi Department of Environmental Quality		Aquifer:	
Driller: Leeper Drilling	Office of Land and Water Resources P.O. Box 10631		Well #: <u>D-50</u>	
Date drilling completed: <u>LEB 28 '07</u>	Jackson, N	AS 39289-0631	L. S. Elevation:	
)961-5210 54-6938 (fax)		
State I am accusion di stati			E-log #:	
State Law requires that this repo 30 days of completion of drilling		e driller in detail and filed w	ith the Department within	
Well Owner Information		Well Location		
Owner Name Buck VArbarough			" Longitude: 88 • 43 · 26.	
Mailing Address: Eucy 746	67 Road	Method of Lat/Long (circle on		
		USGS quad, Hand-held	GPS, Survey-grade GPS	
$\frac{\leq \frac{4}{\text{City}}}{\text{City}}$	$\frac{MS}{\epsilon}$ Zip Code		Twn_ <u>8</u> 5_ Rng_5 ⁻⁵	
Telephone No. (602) 401-10	24	Distance Direction	Nearest Town	
	Well I	Data		
Purpose of Well (circle one) Home Industrial Public Supply Irrigation Fish Culture Other:				
Date well drilling started: <u>7 2 4</u>	t - c - 7 Date w	vell drilling completed: 2	- 28-07	
a no wing, method of now regulation: Valv	e Other (de	escribe)		
Static Water Level: 160 feet abo	ve of below (circle one) la	and surface Date measured	2-28-07	
Method of Measurement (circle one) stee	el tape electric tape	air line other:		
Hole depth: 500 M Well depth	h: 500 jt	Well grouted to a depth of	/ U feet	
Type of grout (circle one): Cement	Bentonite (Mix)		
Casing length: <u>340</u> feet Casing	diameter:	_inches Type of casing:	PUC	
Screen length: <u>40</u> feet Screen	diameter: 2 '	_inches Type of screen:	PVC	
Screen slot size: <u>volu</u> inches Setting depth: From <u>460</u> feet to <u>500</u> feet Type of completion (circle all applicable): Gravel packed Underreamed Telescoped Open hole Natural Development				
Type of completion (circle all applicable): (Gravel packed Underrea	amed Telescoped Open ho	le Natural Development	
m	Other (describe):			
Top of lap pipe or reduction in casing:	fcet. If teles	scoped or more than one screen	, describe on back of page	
Logs run (circle all applicable): No log run	Electric Gamma Ray	Density Sonic Neutron Ot	her;	
Name of organization running log(s):	ad and and to be			
I certify that the well was drilled, construct Department of Environmental Quality and/	or the Mississinni Donor	ordance with all applicable req	uirements of the Mississippi	
		unent of Health regulations an	d state laws.	
Leeper Drilling-	# 0079		repen-	
Print Name of Water Well Contractor and Lic	ense No.	Signature of W	ater Well Contractor	
			NEVEIVED	
			MAR 2 9 2007	
			BY: OLWR	

If well telescopes please sketch below and show depths.

D - 50

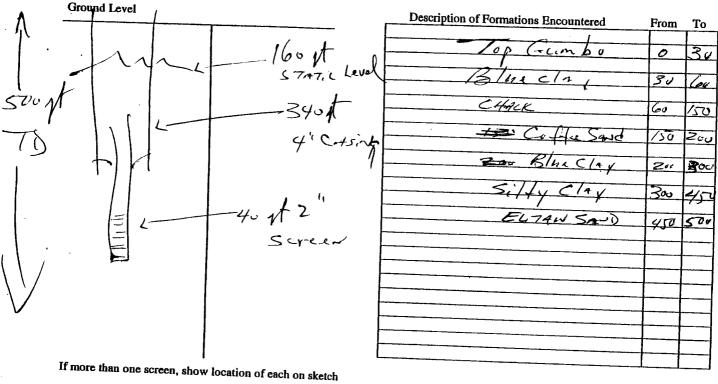

Sketch the property layout and include the following: 1) the well location; 2) any permanent structures on the property that may aid in locating the well; 3) any roads, power lines, or other items that may aid in locating the property and the well; FLICHTABA RAG Arbanous 1cK Landowner Name: Signature of Water Well Contractor

RECEIVED MAR 2 9 2007 BY: OLWR

STAT	E WELL REPORT	
County:	Part 2	
Pump In	staller's Complete The Fan Office Head	
remit #:	partment of Environmental Quality Land and Water Resources For Onice Use Only Aquifer:	
	P.O. Box 10631	
Date completed: 2-28-07 Jac	kson, MS 39289-0631 (601)961-5210 Well #: <u>D-50</u>	
	(001)901-5210 601)354_6039 (cm)	
This report should be prepared by the pump installer i installation of pump.	n detail and filed with the Department within 30 days of the	
Well Owner Information	i uctain and fued with the Department within 30 days of the	
Mailing Address:	Well Location	
Mailing All	Latitude: Longitude: Method of Lat/Long (circle one): Conventional Survey,	
Mailing Address: Elicarables Rot		
Saltilla ME	USGS quad, Hand-held GPS, Survey-grade GP	
Saltilly MS City State Zip Code	¹ /4 Sec Twn_ <u></u> <u>8</u> <u>8</u> Rng	
Telephone No. (667 401 - 1024	Distance Direction Nearest Town	
	MilesNW ofSaltilly	
Ритр Туре		
Circle one	Power Type	
Air Lift Jet Submersible	Circle one	
Bucket	Diesel Engine Gasoline Engine Natural Ga	
Piston Turbine	Electric Motor	
Centrifugal Rotary Flowing Well	Tractor PTC	
Other (specify):	Windmill Other (specify):	
Date Pump Installed: 2-28-07	Horse Power Rating of Motor: 1HP	
	Setting Depth: 210 feet	
Rated Pump Capacity:/ oGallons Per Minute	Number 60 (1	
	Number of Stages:	
Pump Test Data		
Date Well Tested: 2 - 2 8 - 0 7	Method of Measuring Water Level Circle one	
Static Water Level (A): Feet Below Land Surface	Air Line Electric M	
Pumping Water Level (B):Feet Below Land Surface	Other (specify):	
Drawdown [(B) - (A)]:Feet Below Land Surface		
Test Pumping Rate:Gallons Per Minute	For flowing well, measured shut in head:feet	
Duration of Duratio of Duration of Duration of Duration of Duration of Duratio	Well yielded GPM with a drawdown of	
Duration of Pump Test (minimum 4 hours):hours	feet afterhours of pumping	
	hours of pumping	
HEREBY CERTIFY that the above statements are true to the best		
L'EPER DELL'ES TOUTE	of my knowledge.	
Print Name of Pump Installer and License No. (if applicable)	- Kolese - AFINED	
	Signature of Pump Installer	
	MAR 2 9 2007	
	BY: OLWF	

•