

# State Well Report

## Part 1

Mississippi Department of Environmental Quality  
Office of Land and Water Resources  
P.O. Box 10631  
Jackson, MS 39289-0631  
(601)961-5210  
(601)354-6938 (fax)

For Office Use Only:

Aquifer: \_\_\_\_\_  
Well #: E 101  
L. S. Elevation: D52  
E-log #: \_\_\_\_\_

County: LEE  
Permit #: \_\_\_\_\_  
Driller: Leeper Drilling  
Date drilling completed: 6-21-08

State Law requires that this report be prepared by the driller in detail and filed with the Department within 30 days of completion of drilling of the well.

### Well Owner Information

Owner Name: ERIC WEBB  
Mailing Address: # 9 JONES ROAD  
Saltville MS 38866  
City / State / Zip Code  
Telephone No. (662) 869-2962

### Well Location

Latitude: 34° 24' 22" Longitude: 88° 43' 14"  
Method of Lat/Long (circle one): Conventional Survey,  
USGS quad, Hand-held GPS, Survey-grade GPS  
NE 1/4 NE 1/4 Sec 12 Twn 8 S Rng 6 E  
Distance 3 Miles W of Nearest Town SALTVILLE

### Well Data

Purpose of Well (circle one) Home Industrial Public Supply Irrigation Fish Culture Other: \_\_\_\_\_  
Date well drilling started: 6-18-08 Date well drilling completed: 6-21-08  
If flowing, method of flow regulation: Valve \_\_\_\_\_ Other (describe) \_\_\_\_\_  
Static Water Level: 140 feet above or (below) (circle one) land surface Date measured: 6-23-08  
Method of Measurement (circle one) steel tape electric tape air line other: \_\_\_\_\_  
Hole depth: 460 ft Well depth: 46 ft Well grouted to a depth of 10 feet  
Type of grout (circle one): Cement Bentonite Mix  
Casing length: 420 feet Casing diameter: 4" inches Type of casing: PVC  
Screen length: 40 feet Screen diameter: 4" inches Type of screen: PVC  
Screen slot size: 1013 inches Setting depth: From 420 feet to 46 feet  
Type of completion (circle all applicable): Gravel packed Underreamed Telescoped Open hole Natural Development  
Other (describe): \_\_\_\_\_  
Top of lap pipe or reduction in casing: \_\_\_\_\_ feet. If telescoped or more than one screen, describe on back of page  
Logs run (circle all applicable): No log run Electric Gamma Ray Density Sonic Neutron Other: \_\_\_\_\_  
Name of organization running log(s): \_\_\_\_\_

I certify that the well was drilled, constructed, and completed in accordance with all applicable requirements of the Mississippi Department of Environmental Quality and/or the Mississippi Department of Health regulations and state laws.


LEEPER Drilling # 0079  
Print Name of Water Well Contractor and License No.

[Signature]  
Signature of Water Well Contractor

RECEIVED  
JUL 07 2008  
BY: OLWR

E-101

If well telescopes please sketch below and show depths.

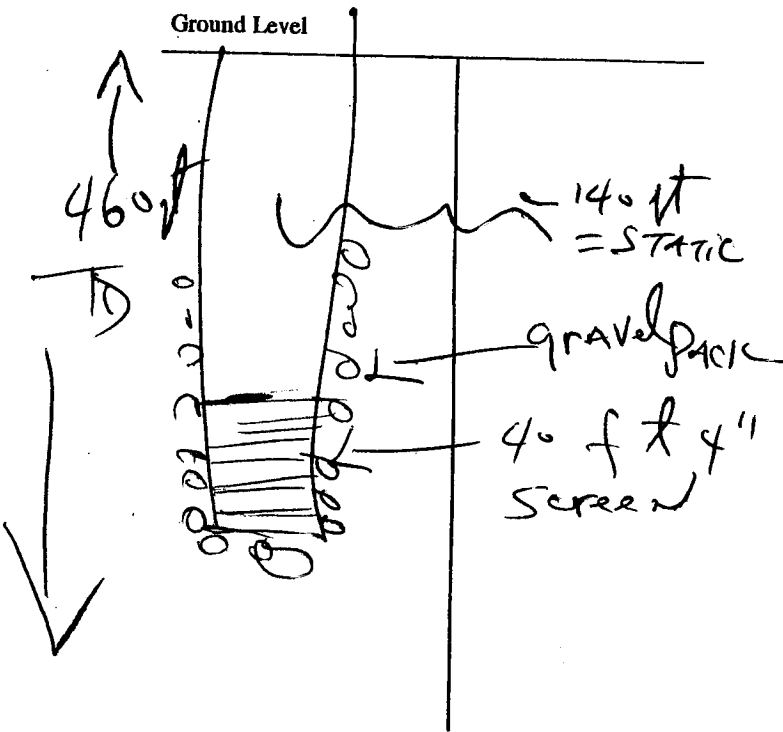

Description of Formations Encountered	From	To
Top Clay	0	30
Blue Clay	30	260
<del>Blue Clay</del>		
Silty green clay	260	380
EUTAW SAND	380	460

If more than one screen, show location of each on sketch

Sketch the property layout and include the following: 1) the well location; 2) any permanent structures on the property that may aid in locating the well; 3) any roads, power lines, or other items that may aid in locating the property and the well; 4) indicate direction.

Landowner Name: ERIC WEBB

Signature of Water Well Contractor *[Handwritten Signature]*

RECEIVED  
 JUL 07 2008  
 BY: OLWR

# STATE WELL REPORT

## Part 2

Pump Installer's Completion Report  
Mississippi Department of Environmental Quality  
Office of Land and Water Resources  
P.O. Box 10631  
Jackson, MS 39289-0631  
(601)961-5210  
(601)354-6938 (fax)

County: Lee  
Permit #: \_\_\_\_\_  
Driller: Leeper Drilling  
Date completed: 6-23-08

For Office Use Only:  
Aquifer: \_\_\_\_\_  
Well #: E-101  
Elevation: \_\_\_\_\_

This report should be prepared by the pump installer in detail and filed with the Department within 30 days of the installation of pump.

Well Owner Information	Well Location
Owner Name: <u>Eric Webb</u>	Latitude: _____ Longitude: _____
Mailing Address: <u>9 Jones Road</u>	Method of Lat/Long (circle one): Conventional Survey, USGS quad, Hand-held GPS, Survey-grade GPS
<u>Saltville MS 38866</u> City / State Zip Code	_____ 1/4 _____ 1/4 Sec <u>12</u> Twn <u>8S</u> Rng <u>6E</u>
Telephone No. <u>(662) 669-2962</u>	Distance _____ Direction _____ Nearest Town _____ <u>3</u> Miles <u>W</u> of <u>SALTVILLE</u>

Pump Type Circle one	Power Type Circle one
Air Lift <input type="checkbox"/> Jet <input type="checkbox"/> <u>Submersible</u>	Diesel Engine <input type="checkbox"/> Gasoline Engine <input type="checkbox"/> Natural Gas <input type="checkbox"/>
Bucket <input type="checkbox"/> Piston <input type="checkbox"/> Turbine <input type="checkbox"/>	<u>Electric Motor</u> <input type="checkbox"/> Hand <input type="checkbox"/> Tractor PTO <input type="checkbox"/>
Centrifugal <input type="checkbox"/> Rotary <input type="checkbox"/> Flowing Well <input type="checkbox"/>	Windmill <input type="checkbox"/> Other (specify): _____
Other (specify): _____	Horse Power Rating of Motor: <u>3 HP</u>
Date Pump Installed: <u>6-23-08</u>	Setting Depth: <u>231</u> feet
Rated Pump Capacity: <u>35</u> Gallons Per Minute	Number of Stages: <u>14</u>

Pump Test Data	Method of Measuring Water Level Circle one
Date Well Tested: <u>6-23-08</u>	Air Line <input type="checkbox"/> Electric Measuring Line <input type="checkbox"/> <u>Steel Tape</u>
Static Water Level (A): <u>140</u> Feet <u>Below</u> Land Surface	Other (specify): _____
Pumping Water Level (B): _____ Feet Below Land Surface	For flowing well, measured shut in head: _____ feet
Drawdown [(B) - (A)]: _____ Feet Below Land Surface	Well yielded _____ GPM with a drawdown of _____ feet after _____ hours of pumping
Test Pumping Rate: _____ Gallons Per Minute	
Duration of Pump Test (minimum 4 hours): _____ hours	

I HEREBY CERTIFY that the above statements are true to the best of my knowledge.

LEEPER Drilling # 0079  
Print Name of Pump Installer and License No. (if applicable)

[Signature]  
Signature of Pump Installer

RECEIVED  
JUL 07 2008  
BY: OLWR