County: Lee
Permit #: MSG-W-17057 √
Driller: Donald Snith Co., Inc
Date drilling completed: 4/16/14

Well Owner Information (Landowner if borehole is not for a water well)

## STATE WELL REPORT

### Part 1

Driller's Log Mississippi Department of Environmental Quality Office of Land and Water Resources P.O. Box 2309 Jackson, MS 39225-2309

(601)961-5210 (601)360-0535 (fax)

For Office Use Only:	
Well #: <u>D 54</u>	
Aquifer:	
E-Log #:	

Form: OLWR-SWR-1A (4/13)

Well or Borehole Location

Latitude: 34° 20' 44.63 "Longitude: 88' 47' 19.99" W

State Law requires that this report be prepared by the license holder responsible for the work and filed with the Department at the above address within 30 days of completion of drilling of the well or borehole.

Owner Name: J 3 L L C	A5 QC		
Mailing Address: PO Box 1485	Method of Lat/Long (check one): Conventional Survey,		
Gin Well	USGS quad, Hand-held GPS_X_, Survey-grade GPS		
Saltillo MS 38866	50 14 NW 14, Sec 33 T 85 R 5E		
City State Zip Code	Miles of		
Telephone No. ()	(Distance) (Direction) (Nearest Town)		
Well / B	Borehole Data		
	: 4/16/14 Hole depth: 692 Hole diameter: 97/8"		
	ing: Public Water Supply		
Method of dosing and volume of Chlorine used in drilling a	and development: Potable Water Used		
Logs run (circle all applicable): No log run Electric Gamma Ray Density Sonic Neutron Other:			
Name of organization running log(s): Donald Smi	th Company INC		
Purpose of borehole (circle one): Water Well Geotechn			
Seismic Survey Other	(describe)		
If drilling is not related to water well o	construction, skip the remainder of this block		
Purpose of Well (circle all applicable): Home Industrial	Public Supply Irrigation Fish Culture		
Other (describe):			
If a flowing well, method of flow regulation: Valve	Other (describe)		
Static Water Level: 137 feet [above or (below (circle one)	williand surface Date measured: 4\07\14		
Method of measurement (circle one): Steel tape (Electric	tape Air line Other (describe):		
Well depth: <u>4つつ</u> Well grouted to a depth of: <u>4つつ</u>	feet Type of grout (circle one) Neat Cement Bentonite Mix		
Casing length: 470 feet Casing diameter:	8 inches Type of casing: 5+cel		
Screen length: 60 feet Screen diameter:	4 inches Type of screen: Stainless St		
Screen slot size: <u>025</u> inches Setting depth	n: From 575 feet to 635 feet		
Type of completion (circle all applicable). Gravel packed	Underreamed Open hole Natural Development		
Other (describe):	• •		
Top of lap pipe or reduction in casing: 515 feet	Pro L. 2 - Francis		
	one screen, describe on next page		


County:	Lec
Permit #:	MSGW-MOST

For	Office	Use	Only:	
oll #:	154			

## The sketch below only required for water wells

If well telescopes, show depths on sketch.

<u>Description of formations encountered must be provided for all wells</u> and boreholes, unless specifically exempted by regulations

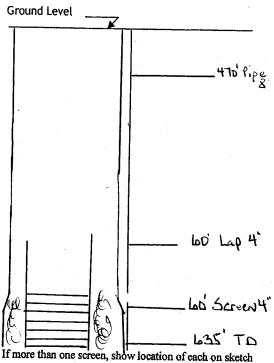

Print Name of Responsible Licensee and License No.

Description of Family 5		
Description of Formations Encountered	From (depth)	To (depth)
	Ground level	
Brown Clay, Medium	0	. 18
Gray Clay Hard	18	110
Rock Hard	110	11.1
Sand Soft	111	200
Blue Clay & Sand Stks, Mer	200	220
Blue Clay Med	220	244
Rock, Hard	244	245
BlueClay & Sand Stks Med	245	425
Saud wi Blue Clay Stks, Me	ط 425	<b>L38</b>
Blue Clay & Saud 5+KS, Me	4 638	0هاما
Gray Clay Hard	0ماما	689
Pink Clay Mard	689	692

Hober L. C

### STATE WELL REPORT

# County: Lee Permit #: MSGW-17057 Driller: Nowld Swith Contre Date completed: \_5[13]14 Copy information from block on Part 1

### Part 2

# Pump Installer's Completion Report Mississippi Department of Environmental Quality

Aississippi Department of Environmental Quality Office of Land and Water Resources P.O. Box 2309 Jackson, MS 39225-2309 (601)961-5210 (601) 360-0535 (fax)

For Office Use Only:	•
Well #: <u>D54</u>	
Aquifer:	

This part of the report must be completed by a licensed water well contractor or a licensed pump installer. A copy of Part 1 of the report must be attached and both parts filed with the Department at the above address within 30 days of well completion.

Well Owner Information Well Location

Well Owner Information	Well Location	
Owner Name: JS LLC	Latitude: 34° 20' 44.63 Longitude: 88° 47' 19.99" W	
Mailing Address: PO BOX 1485	Method of Lat/Long (check one): Conventional Survey,	
Gin Well	USGS quad, Hand-held GPS_X_, Survey-grade GPS	
Saltillo MS 388106 City State Zip Code	<u>5W 14 NW 14, Sec 33 T 85 R 5E</u>	
•	Miles of (Distance) (Direction) (Nearest Town)	
Telephone No. ()	(Distance) (Direction) (Nearest Town)	
Pump Ty	pe (circle one)	
Submersible Turbine Air Lift Centrifugal Flowing Well	Jet Piston Rotary Other (describe):	
Date Pump Installed: 04/18/14	Rated Pump Capacity:	
Is This Pump (circle one): (New) Repaired Replaceme		
Power Ty	pe (circle one)	
Electric Diesel Gasoline Natural Gas Tractor PTO Win	dmill Other (describe):	
Horse Power Rating of Motor: 20 Setting Depth: 231 feet Number of Stages: 10		
Pump Test Data for Non Flowing Well		
Date Well Tested: 4 2 1 14 Duration of Pump Test (minimum 4 hours): 4 hours		
Static Water Level (A): 137 Feet Below Land Surface Pumping Water Level (B): 172 Feet Below Land Surface		
_	face Test Pumping Rate: 170 Gallons Per Minute	
Method of measurement (circle one): Steel tape (Electric to	Air line Other (describe):	
Pump Test Da	ta for Flowing Well	
Measured shut in head:feet.		
Well yieldedGPM with a drawdown of	feet afterhours of pumping	
Meter	Installation	
Meter Manufacturer:	Meter Serial Number:	
Meter Model Number/Name: Type of Meter:		
Totalizer Register Unit and Multiplier Factor (AF x .001, gal x 1000, etc):		
Installation Date: Meter installed by:		
Is This Meter (circle one): New Repaired Replacement		
Important: By submitting the above information you are certifying that this meter was installed to manufacturer standards. For agricultural wells, a list of approved meters is on the MDEQ website.		
	Sinha stone on	

I HEREBY CERTIFY that the above statements are true to the	best of my kno	wledge.
Robert L Young, Jr UNR-5671	5/13/14	Robert L. younals
Print Name of Pump Installer and License No. (if applicable)	'Date	Signature of Pump Installer

Form: OLWR-SWR-1B (4/13)