

D 2000
2-11-62

WATER WELL DRILLERS LOG

Date: 2-11, 1962, Driller: C. C. Welch County Permittee
(Name)

	Description & Color of Materials Sand, Clay, Red Clay, Shell, etc.	Thick- ness Feet	Depth Feet
(1) Owner of Land: <u>Mitchell Crump</u> (Name)	<u>Soil 16ft white</u>		
<u>Belden</u> (Address)	<u>Rock to 30ft</u>		
(2) Location: <u>1/4, SW 1/4, Sec. 13 T. 9 R. 4 E</u>	<u>Blue Rock to 320</u>		
<u>9</u> miles <u>North West</u> of <u>Supelo</u>	<u>ft water Rock</u>		
(distance) (direction) (Nearest Town)	<u>1ft water sand</u>		
(3) Topography: <input checked="" type="checkbox"/> (Hilly) <input type="checkbox"/> (Flat) <input type="checkbox"/> (Level)	<u>to 400ft coffee</u>		
(4) Purpose of Well: <input checked="" type="checkbox"/> (Domestic Irrigation) <input type="checkbox"/> (Municipal, Industrial, Other)	<u>sand</u>		


Information upon completion of well:

- (1) Diameter 4 inches.
- (2) Total Depth 400 feet.
- (3) Water Level 160 feet below top of ground.
- (4) Cased to 42ft, Size 4'
- (5) Screen: Size _____, Length _____
- (6) Were any formations sealed against pollution?
_____ yes, _____ no.

If YES depth of formation _____

Why _____

Drillers Remarks: _____

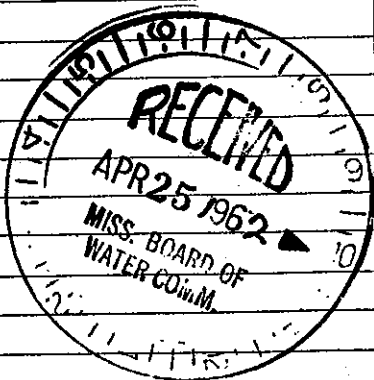

Well No.

(Use Back Side)