

MISSISSIPPI BOARD OF WATER COMMISSIONERS

WATER WELL DRILLERS LOG


LEE
E 14
7-16-63

Date: 7-16-, 19 63, Driller: Layne-Central Co., County Lee
(Name)

| (1) Owner of Land: City water Works (Name) Saltillo, Mississippi (Address) | Description & Color of Materials Sand, Clay, Red Clay, Shell, etc. | Thick- ness depth | Depth Feet thick |
|---|--|-------------------------|------------------------|
| | (2) Location: 1/4, 1/4, Sec. 17 1/2 T. 8 R. 6, miles, of (distance) (direction) (Nearest Town) | sandy clay | 0 |
| (3) Topography: (Hilly) (Flat) (Level) | blue clay | 18 | 88 |
| (4) Purpose of Well: municipal (Domestic Irrigation Municipal, Industrial, Other) | rock | 88 | 89 |
| | clay | 89 | 120 |
| | rock | 120 | 121 |
| | clay | 121- | 311 |
| | sandy shale | 311 | 403 |
| | fine sand, shale stks | 403 | 472 |
| | fine sand | 472 | 537 |
| | shale | 537 | 585 |

Information upon completion of well:

- (1) Diameter 10" inches.
- (2) Total Depth 542' 8" feet.
- (3) Water Level 56' feet below top of ground.
- (4) Cased to 472', Size
- (5) Screen: Size 6", Length 60'
- (6) Were any formations sealed against pollution?
 yes, no.
 If YES, depth of formation 472'
 Why required
 Drillers Remarks:

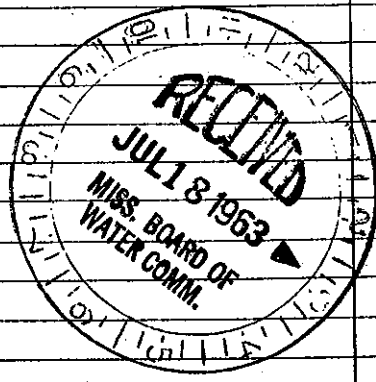

90 ✓ ELEV 315

(Use Back Side)

Well No.

Mail this copy to Board of Water Commissioners 429 Miss. St. Jackson, Miss.