

LEE

MISSISSIPPI BOARD OF WATER COMMISSIONERS

E 15

WATER WELL DRILLERS LOG

7-25-60

E303

Date: 7-25, 1960, Driller: C.C. Webb County Lee

(Name)

(1) Owner of Land:	Description & Color of Materials Sand, Clay, Red Clay, Shell, etc.	Thick- ness Feet	Depth Feet
J. W. Spicer (Name) Lupelo Miss (Address)	soil to 15 ft sand & clay to 145 ft blue rock to 400 ft water sand to 550 ft		
(2) Location: 1/4, 1/4, Sec. 8 3 E 4 T8 R6 9 miles north of Sallis (distance) (direction) (Nearest Town)			
(3) Topography: <input checked="" type="checkbox"/> (Hilly) <input type="checkbox"/> (Flat) <input type="checkbox"/> (Level)			
(4) Purpose of Well: <input checked="" type="checkbox"/> (Domestic Irrigation) <input type="checkbox"/> (Municipal, Industrial, Other)			

Information upon completion of well:


- (1) Diameter 4 inches.
- (2) Total Depth 550 feet.
84.92 7/15/67
- (3) Water Level 100 feet below top of ground.
- (4) Cased to 200, Size 4 in.
- (5) Screen: Size _____, Length _____.
- (6) Were any formations sealed against pollution?
_____ yes, no.

If YES depth of formation _____

Why _____

Drillers Remarks: Feed mill

61 ELEV 370

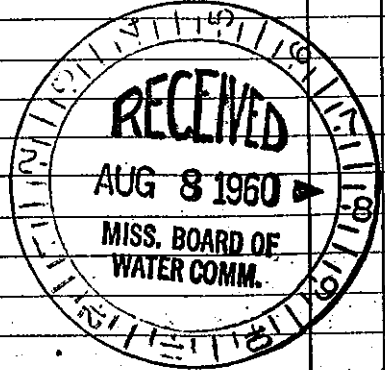

Well No. E303

(Use Back Side)

Mail this copy to Board of Water Commissioners 429 Miss. St. Jackson, Miss