

MISSISSIPPI BOARD OF WATER COMMISSIONERS

LEE

E 16
8-25-60

WATER WELL DRILLERS LOG

E301

Herndon Well & Supply Co.

Date: Aug 25, 1960, Driller: SHANNON, MISS. County: Lee

(Name)

	Description & Color of Materials Sand, Clay, Red Clay, Shell, etc.	Thick- ness Feet	Depth Feet
(1) Owner of Land: <u>CC Wages</u> (Name) <u>Saltville, Mississippi</u> (Address)	<u>Sand & Clay</u> <u>Blue Rock</u>		<u>168</u>
(2) Location: <u>1/4, 1/4, Sec. 17 T8 R6,</u> <u>_____ miles _____ of <u>Saltville</u></u> (distance) (direction) (Nearest Town)	<u>Sand</u> <u>Bottom</u>		<u>320</u> <u>420</u>
(3) Topography: <u>Flat</u> (Hilly) (Flat) (Level)			
(4) Purpose of Well: <u>Home Use</u> (Domestic Irrigation Municipal, Industrial, Other)			

Information upon completion of well:


- (1) Diameter 4 inches.
- (2) Total Depth 420 feet.
- (3) Water Level 50 feet below top of ground.
- (4) Cased to 168 ft. Size 4 inch
- (5) Screen: Size _____, Length _____
- (6) Were any formations sealed against pollution?
 yes, _____ no.

If YES depth of formation 168 ft
Why Sand & Surface

Drillers Remarks: 1 block N. of

post office E. side of road
24 ELEV 325

well house & fallout
shelter together
Magnolia tree across
road

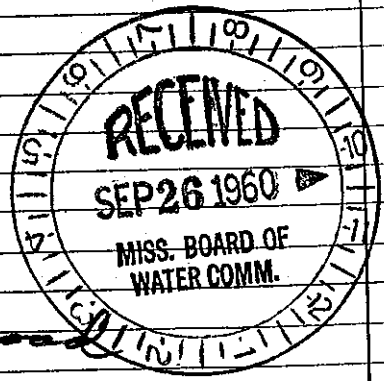

Well No.
E301

(Use Back Side)

Mail this copy to Board of Water Commissioners 429 Miss. St. Jackson. Miss