

MISSISSIPPI BOARD OF WATER COMMISSIONERS

WATER WELL DRILLERS LOG

LEE
E 17
9-10-60

Date: 9-10, 1960, Driller: Ewing Gasco, County Lee


(1) Owner of Land: Mr. John Rial
(Name)
Saltville, Miss.
(Address)

(2) Location: 1/4, 1/4, Sec. 20 T8R6
miles, of (Nearest Town)

(3) Topography: (Hilly) (Flat) (Level)

(4) Purpose of Well: Home hold
(Domestic Irrigation, Municipal, Industrial, Other)

| Description & Color of Materials Sand, Clay, Red Clay, Shell, etc. | Thick- ness Feet | Depth Feet |
|---|------------------------|---------------|
| | | |
| Red brick house and well house | | |

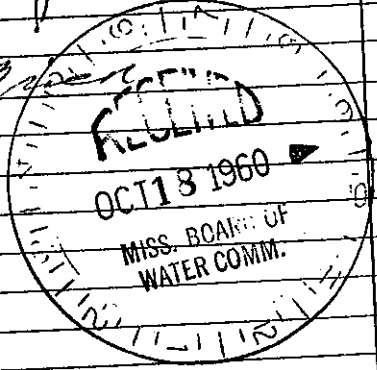

Information upon completion of well:

- (1) Diameter 4 inches.
- (2) Total Depth 474 feet.
- (3) Water Level 90 feet below top of ground.
- (4) Cased to 192', Size _____
- (5) Screen: Size _____, Length _____
- (6) Were any formations sealed against pollution?
 yes, _____ no.
 If YES depth of formation 192'
- Why _____
- Drillers Remarks: _____

68 ✓ ELEV 355

Well No.

(Use Back Side)