

MISSISSIPPI BOARD OF WATER COMMISSIONERS

LEE
E18
11-14-60

WATER WELL DRILLERS LOG

4305

Herndon Well & Supply Co.

Date: Nov 14, 1960, Driller: SHANNON, MISS. County L...

(Name)

	Description & Color of Materials Sand, Clay, Red Clay, Shell, etc.	Thick- ness Feet	Depth Feet
(1) Owner of Land: <u>Tom Smith</u> (Name) <u>Sa Hills Mississippi</u> (Address)	<u>Sand & Clay</u>		
(2) Location: <u>1/4, 1/4, Sec. 21 T8 R6</u> <u>_____</u> miles <u>_____</u> of <u>_____</u> (distance) (direction) (Nearest Town)	<u>Blue Shale</u>		<u>195</u>
(3) Topography: <u>Hills</u> (Hilly) (Flat) (Level)	<u>Sand</u>		<u>350</u>
(4) Purpose of Well: <u>Home Use</u> (Domestic Irrigation Municipal, Industrial, Other)	<u>Bottom</u>		<u>465</u>


Information upon completion of well:

- (1) Diameter 4 inches.
- (2) Total Depth 465 feet.
- (3) Water Level 80 feet below top of ground.
- (4) Cased to 200' 4", Size 4"
- (5) Screen: Size _____, Length _____
- (6) Were any formations sealed against pollution?
X yes, _____ no.

If YES depth of formation 195

Why Some Sand & Sand
Cartwright
Drillers Remarks: subdivision
in S.W. part of town

W.L. RHP 365

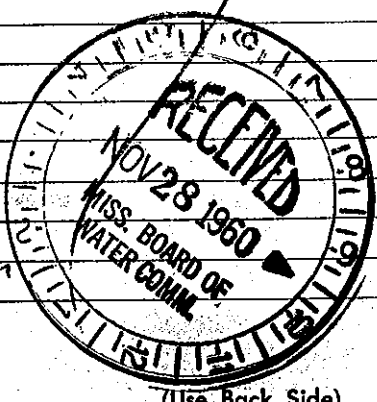

Well No.