

LEE MISSISSIPPI BOARD OF WATER COMMISSIONERS

E 19
5-15-62

WATER WELL DRILLERS LOG

HERNDON WELL & SUPPLY CO.


Date: May 15, 1962, Driller: HERNDON P. O. BOX 42 County Lee
SHANNON, MISSISSIPPI

	Description & Color of Materials Sand, Clay, Red Clay, Shell, etc.	Thick- ness Feet	Depth Feet
(1) Owner of Land: <u>W. S. Jones</u> (Name) <u>Saltville, Miss</u> (Address)	<u>Surface sand</u>		<u>0</u>
(2) Location: <u>NW 1/4, SE 1/4, Sec 5, T. 8 S, R. 6 E</u> <u>2 miles NE</u> of <u>Saltville</u> (distance) (direction) (Nearest Town)	<u>Thin rock</u>		<u>15</u>
(3) Topography: <u>Hilly</u> (Hilly) (Flat) (Level)	<u>Sand</u>		<u>25</u>
(4) Purpose of Well: <u>Domestic</u> (Domestic Irrigation Municipal, Industrial, Other)	<u>Bottom</u>		<u>140</u>

Information upon completion of well:

- (1) Diameter 4 inches.
- (2) Total Depth 140 feet.
- (3) Water Level 30 feet below top of ground.
- (4) Cased to 19', Size 4"
- (5) Screen: Size —, Length —
- (6) Were any formations sealed against pollution?
 yes, no.

If YES depth of formation 15'
Why Surface & sand
Drillers Remarks: _____

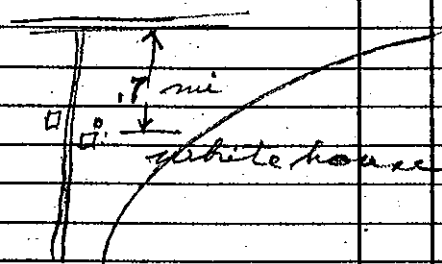

(83) ELEV 380

Well No.