

LEE

MISSISSIPPI BOARD OF WATER COMMISSIONERS

E 20


9-3-62

WATER WELL DRILLERS LOG

HERNDON WELL & SUPPLY CO.

Date Sept 3, 1962, Driller: P. O. BOX 42 SHANNON, MISSISSIPPI County Lee

(1) Owner of Land	Description & Color of Materials Sand, Clay, Red Clay, Shell, etc.	Thick- ness Feet	Depth Feet
Elsie Vandy (Name) Sattilo, Miss. (Address)	Surface sand & clay		0
(2) Location: 1/4, 1/4, Sec 19 T 85 R 6 E 1 miles W, of Sattilo (distance) (direction) (Nearest Town)	Blue rock to sand		40 80
(3) Topography: Flat (Hilly) (Flat) (Level)	Hard rock		600
(4) Purpose of Well: Domestic (Domestic Irrigation Municipal, Industrial, Other)	to Blue rock		120
Information upon completion of well:	to sand		310
(1) Diameter 4 inches.	Hard rock		331
(2) Total Depth 420 feet.	to sand		332
(3) Water Level 30 feet below top of ground.	Bottom		420
(4) Cased to 182 ft, Size 4"			
(5) Screen: Size _____, Length _____			
(6) Were any formations sealed against pollution? yes, no.			
If YES depth of formation 121			
Why Surface & sand			
Drillers Remarks:			
87 ELEV 305			

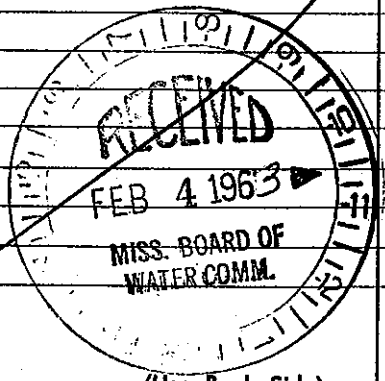

(Use Back Side)

Well No.