

LEE

MISSISSIPPI BOARD OF WATER COMMISSIONERS

E 21
9-23-63

WATER WELL DRILLERS LOG

Date: Sept 23, 1963, Driller: Otto Wehl, Jr., County: Lee
(Name)

(1) Owner of Land: <u>V. C. Rogers</u> (Name)	Description & Color of Materials Sand, Clay, Red Clay, Shell, etc.	Thick- ness Feet	Depth Feet
(Address)	<u>Red Clay</u>	<u>0</u>	<u>15</u>
(2) Location: <u>1/4</u> , <u>1/4</u> , Sec. <u>25</u> T. <u>8</u> R. <u>6</u> E	<u>Red Sand</u>	<u>15</u>	<u>40</u>
<u>4</u> miles <u>E</u> of <u>SALT HILL</u> (distance) (direction) (Nearest Town)	<u>Blue Sand</u>	<u>40</u>	<u>120</u>
(3) Topography: <u>Hilly</u> (Hilly) (Flat) (Level)	<u>Blue MARL</u>	<u>130</u>	<u>300</u>
(4) Purpose of Well: <u>DOMESTIC</u> (Domestic Irrigation Municipal, Industrial, Other)	<u>Blue Sand</u>	<u>300</u>	<u>440</u>

Information upon completion of well:

- (1) Diameter 4 inches.
- (2) Total Depth 440 feet. 211.5 10-5-67
- (3) Water Level 180 feet below top of ground.
- (4) Cased to 147, Size 4"
- (5) Screen: Size _____, Length _____
- (6) Were any formations sealed against pollution?
_____ yes, _____ no.


If YES depth of formation _____

Why _____

Drillers Remarks: No L. Co. here

measured in hand.

91 ELEV 435

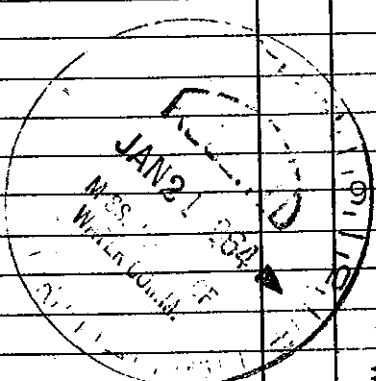

185
211
274

(Use Back Side)

Well No.

Mail this copy to Board of Water Commissioners 429 Miss. St. Jackson, Miss.