

LEE

MISSISSIPPI BOARD OF WATER COMMISSIONERS

41.7

E 22

WATER WELL DRILLERS LOG

10-8-65

Herndon-Homan Well & Supply, Inc.

Date: 10-8, 1965, Driller: P. O. Box 42 County Lee

SHANNON, MISSISSIPPI 38868

(1) Owner of Land:	Description & Color of Materials Sand, Clay, Red Clay, Shell, etc.	Thick- ness Feet	Depth Feet
<u>Charles Brazel</u> (Name)	<u>surface sand & clay</u>		<u>0-10</u>
<u>At 2 SATTILA Miss</u> (Address)	<u>Blue clay & sand</u>		<u>10-35</u>
(2) Location: <u>1/4</u> , <u>1/4</u> , Sec. <u>29</u> T. <u>8S</u> R. <u>6E</u>	<u>Blue clay</u>		<u>35-80</u>
<u>1</u> miles <u>S</u> , of <u>SATTILA</u> (distance) (direction) (Nearest Town)	<u>sand</u>		<u>80-188</u>
(3) Topography: <u>Hilly</u> (Hilly) (Flat) (Level)	<u>Blue clay</u>		<u>188-260</u>
(4) Purpose of Well: <u>Domestic</u> (Domestic Irrigation Municipal, Industrial, Other)	<u>sand</u>		<u>260-350</u>
	<u>Bottom</u>		<u>350</u>


Information upon completion of well:

- (1) Diameter 4 inches.
- (2) Total Depth 350 feet.
- (3) Water Level 60 feet below top of ground.
- (4) Cased to 202', Size 4"
- (5) Screen: Size , Length
- (6) Were any formations sealed against pollution?
 yes, no.

If YES depth of formation 188'

Why surface & sand

Drillers Remarks: South of main plant

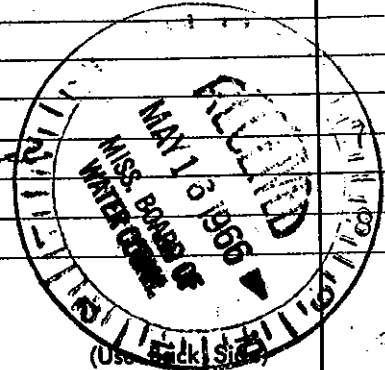

Well No.

94 E.F.V. 305