

MISSISSIPPI BOARD OF WATER COMMISSIONERS

E 23

WATER WELL DRILLERS LOG

Date: 10/, 1966, Driller: J. W. G. Co. County Lee
(Name)

		Description & Color of Materials Sand, Clay, Red Clay, Shell, etc.	Thick- ness Feet	Depth Feet
(1) Owner of Land: <u>T. E. Flanagan</u> <small>(Name)</small>		<u>red clay</u>	<u>10</u>	<u>10</u>
<u>Leathville</u> <small>(Address)</small>		<u>sand</u>	<u>55</u>	<u>65</u>
(2) Location: <u>1/4</u> , <u>1/4</u> , Sec. <u>8</u> T <u>2</u> R <u>6</u> <small>(distance) (direction) (Nearest Town)</small>		<u>Blue</u>	<u>10</u>	<u>75</u>
		<u>sand</u>	<u>120</u>	<u>195</u>
(3) Topography: <u>Hilly</u> <small>(Hilly) (Flat) (Level)</small>		<u>Blue</u>	<u>159</u>	<u>354</u>
(4) Purpose of Well: <small>(Domestic Irrigation, Municipal, Industrial, Other)</small>		<u>sand</u>	<u>120</u>	<u>474</u>

Information upon completion of well:

(1) Diameter 4 inches.

(2) Total Depth 474 feet.

(3) Water Level _____ feet below top of ground.


(4) Cased to 208 ft., Size 4 in.

(5) Screen: Size _____, Length _____

(6) Were any formations sealed against pollution?
 _____ yes, _____ no.

If YES depth of formation _____

Why _____

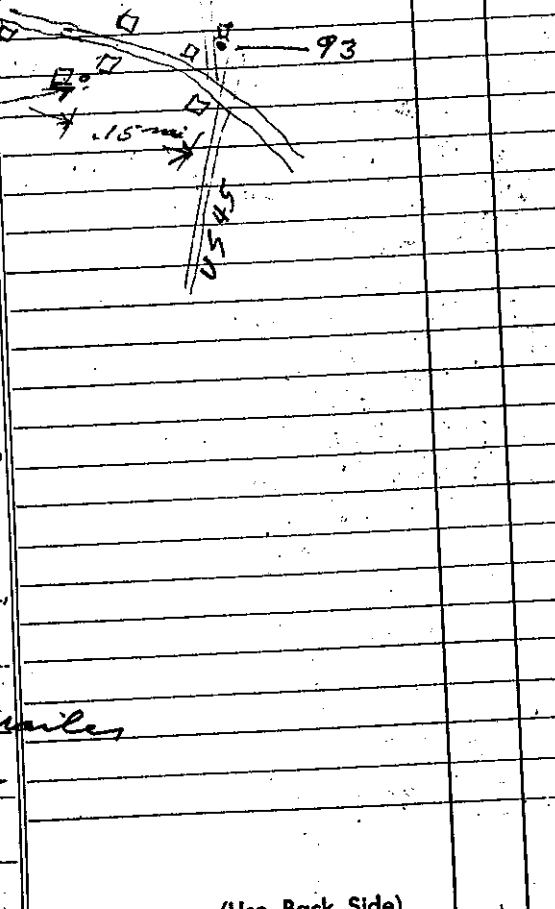

Drillers Remarks: House & Home trailers
3rd house on left

354 BLAV 360

(Use Back Side)

Well No.