

LEE
E 24
8-65


MISSISSIPPI BOARD OF WATER COMMISSIONERS

WATER WELL DRILLERS LOG

Date: August, 1965, Driller: Johnny Wehd County Lee
(Name)

(1) Owner of Land:	Description & Color of Materials Sand, Clay, Red Clay, Shell, etc.	Thick- ness Feet	Depth Feet
Earl Murphy (Name) Saltville Mississippi (Address)	Red sand & clay to sand to 40'	15'	
(2) Location: 1/4, 1/4, Sec. 8, T8R6, S5E	Blue Marl mixed with sand to 45'		
1 miles N-W of Saltville (distance) (direction) (Nearest Town)	Blue Marl to 56'		
(3) Topography: X (Hilly) (Flat) (Level)	Sand to 150'		
(4) Purpose of Well: Domestic (Domestic Irrigation Municipal, Industrial, Other)	Blue Marl mixed with sand to 220'		
Information upon completion of well:			
(1) Diameter 4 inches.			
(2) Total Depth 220 feet.			
(3) Water Level 45 feet below top of ground.			
(4) Cased to 48', Size 4"			
(5) Screen: Size _____, Length _____			
(6) Were any formations sealed against pollution? _____ yes, _____ no.			
If YES depth of formation _____			
Why _____			
Drillers Remarks: _____			

9.3 ELEV 365			

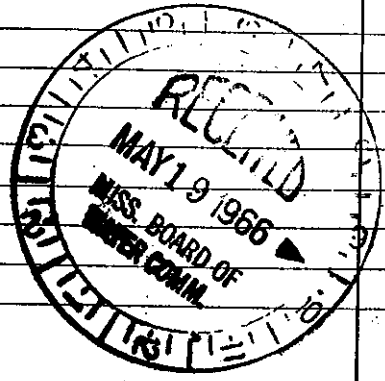

(Use Back Side)

Well No.

Mail this copy to Board of Water Commissioners 429 Miss. St. Jackson, Miss.