

LEE  
E 25  
6-8-62

MISSISSIPPI BOARD OF WATER COMMISSIONERS

WATER WELL DRILLERS LOG  
HERNDON WELL & SUPPLY CO.

Date: June 8, 1962 Driller: SHANNON, MISSISSIPPI County Lee  
P. O. BOX 42  
(Name)

(1) Owner of Land:	Description & Color of Materials Sand, Clay, Red Clay, Shell, etc.	Thick- ness Feet	Depth Feet
<u>Bob Stewart</u> (Name) <u>Sattilla, Miss</u> (Address)	<u>Surface sand &amp; clay</u>		<u>0</u>
(2) Location: <u>1/4, 1/4, Sec. 8 T8 R6</u> <u>1</u> miles <u>N</u> of <u>Sattilla</u> (distance) (direction) (Nearest Town)	<u>Blue granite</u>		<u>35</u>
(3) Topography: <u>Hilly</u> (Hilly) (Flat) (Level)	<u>Sand</u>		<u>50</u>
(4) Purpose of Well: <u>Domestic</u> (Domestic Irrigation Municipal, Industrial, Other)	<u>Bottom</u>		<u>140</u>



Information upon completion of well:

- (1) Diameter 4 inches.
- (2) Total Depth 140 feet.
- (3) Water Level 50 feet below top of ground.
- (4) Cased to 38'7", Size 4"
- (5) Screen: Size \_\_\_\_\_, Length \_\_\_\_\_
- (6) Were any formations sealed against pollution?  
 yes, \_\_\_\_\_ no.

If YES depth of formation 35'

Why Surface & sand

Drillers Remarks: \_\_\_\_\_

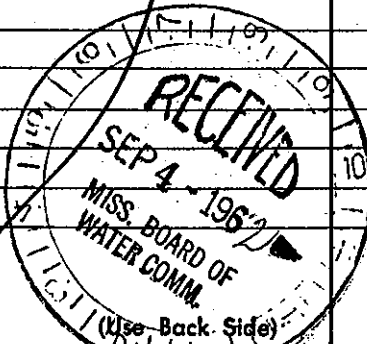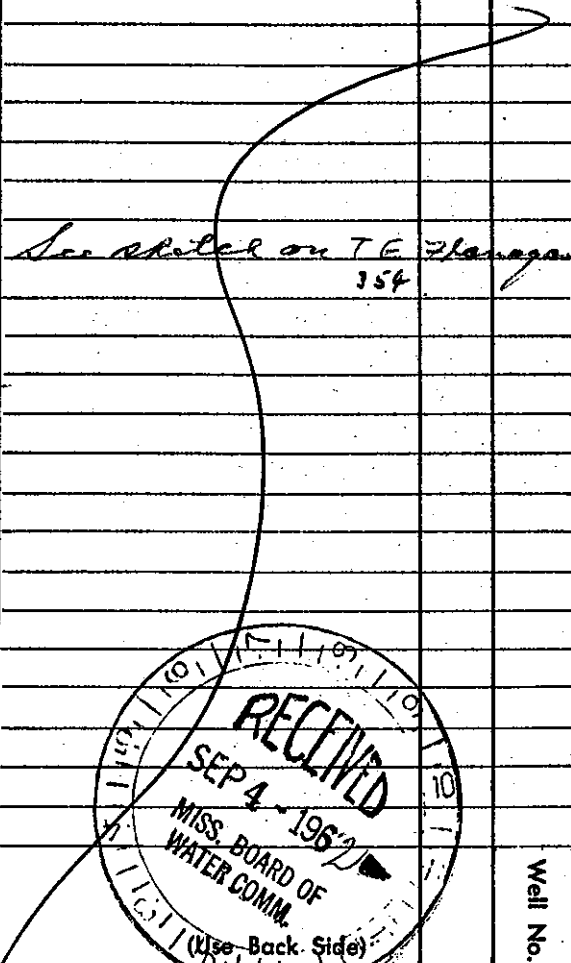

Well No.

84 ELEV 360