

MISSISSIPPI BOARD OF WATER COMMISSIONERS

LEE
E 26
5-11-61

WATER WELL DRILLERS LOG

~~F 208~~

HERNDON WELL & SUPPLY CO.



Date: May 11, 1961, Driller: HERNDON WELL & SUPPLY CO. P. O. BOX 42 County Lee
SHANNON, MISSISSIPPI

	Description & Color of Materials Sand, Clay, Red Clay, Shell, etc.	Thick- ness Feet	Depth Feet
(1) Owner of Land: <u>Lewis DUNAWAY</u> (Name) <u>Saltville, Miss.</u> (Address)	<u>Surface sand</u> <u>+ clay</u>		<u>0</u>
(2) Location: <u>1/4, 1/4, Sec. 8 T. 8 R. 6 E</u> <u>1</u> miles <u>N.W.</u> of <u>Saltville</u> , (distance) (direction) (Nearest Town)	<u>Blue rock</u> <u>S</u> <u>sand</u> <u>S</u>	<u>180</u> <u>340</u>	
(3) Topography: <u>Hilly</u> (Hilly) (Flat) (Level)	<u>Bottom</u>	<u>460</u>	
(4) Purpose of Well: <u>Home use</u> (Domestic Irrigation Municipal, Industrial, Other)			

Information upon completion of well:

- (1) Diameter 4 inches.
- (2) Total Depth 460 feet.
- (3) Water Level 80 feet below top of ground.
- (4) Cased to 189' 8", Size 4
- (5) Screen: Size —, Length —
- (6) Were any formations sealed against pollution?
yes, no.

If YES depth of formation 185 ft
Why Surface & sand
Drillers Remarks:

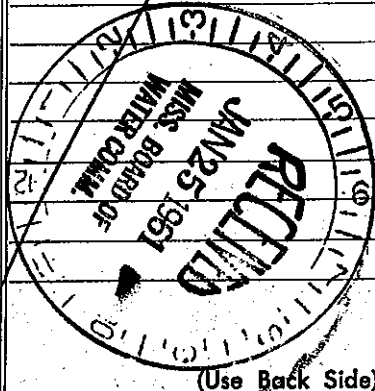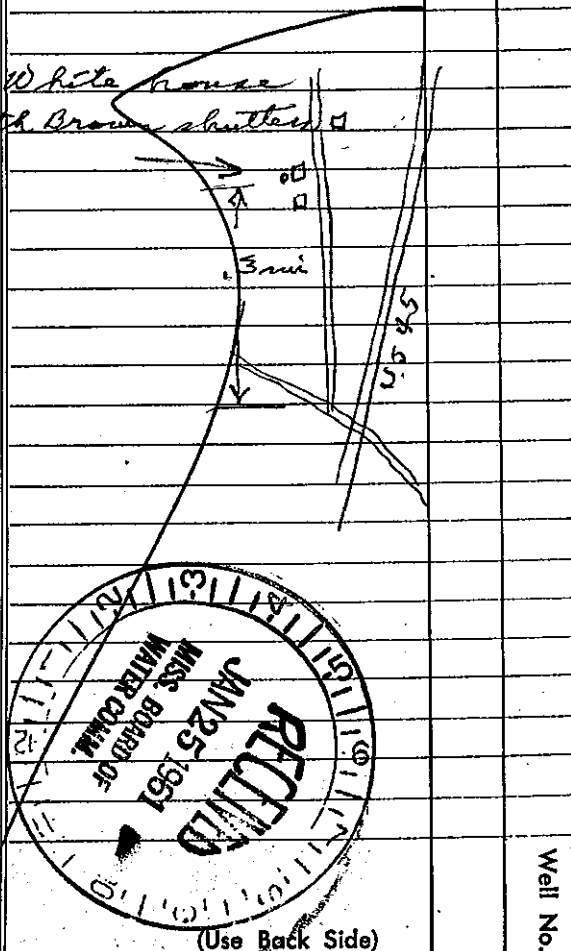

74 ELEV 365

Well No.

(Use Back Side)