

LEE

MISSISSIPPI BOARD OF WATER COMMISSIONERS

E 27

9-2-61

WATER WELL DRILLERS LOG
HERNDON WELL & SUPPLY CO.

0306

P. O. BOX 42

Date: 9/2, 1961, Driller: SHANNON, MISSISSIPPI County Lee

(Name)

(1) Owner of Land:	Description & Color of Materials Sand, Clay, Red Clay, Shell, etc.	Thick- ness Feet	Depth Feet
Bill Cherry (Name) Sallis, Miss. (Address)	surface sand & clay		0
(2) Location: 1/4, 1/4, Sec 20 T 45 R 6 E miles, of Sallis, (distance) (direction) (Nearest Town)	Blue rock & sand		200 340
(3) Topography: Hilly (Hilly) (Flat) (Level)	Bottom		460
(4) Purpose of Well: Domestic (Domestic Irrigation Municipal, Industrial, Other)			

Information upon completion of well:

- (1) Diameter 4 inches.
- (2) Total Depth 460 feet.
- (3) Water level 2.5 feet below top of ground.
- (4) Cased to 208' 6", Size 4"
- (5) Screen: Size _____, Length _____
- (6) Were any formations sealed against pollution?
 yes, _____ no.



If YES depth of formation 200 ft

Why surface & sand

Drillers Remarks: on hill on

right off 45 behind store

80 ELEV 325

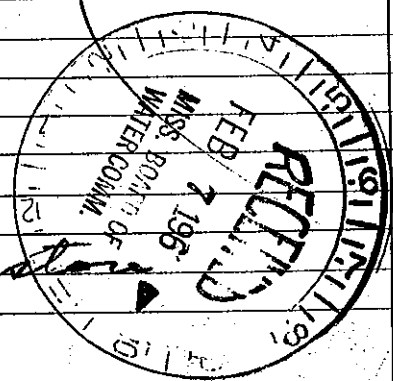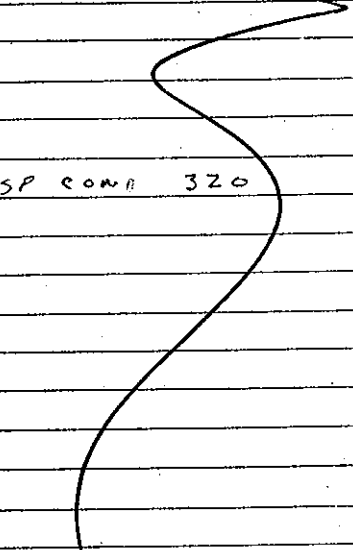

(Use Back Side)

Well No.