

MISSISSIPPI BOARD OF WATER COMMISSIONERS

WATER WELL DRILLERS LOG

LEE  
E-28  
9-1-60

Date: 9-1, 1960, Driller: Ewing Gas Co. County Lee  
(Name)

	Description & Color of Materials Sand, Clay, Red Clay, Shell, etc.	Thick- ness Feet	Depth Feet
(1) Owner of Land: <u>Mrs. Dill McCully</u> (Name)			
<u>Saltillo, Miss.</u> (Address)			
(2) Location: <u>SE 1/4, SW 1/4, Sec. 10 T. 8 R. 6 E.</u>			
_____ miles _____ of _____ (distance) (direction) (Nearest Town)			
(3) Topography: _____ (Hilly) (Flat) (Level)			
(4) Purpose of Well: <u>House hold</u> (Domestic Irrigation Municipal, Industrial, Other)			


Information upon completion of well:

- (1) Diameter 4 inches.
- (2) Total Depth 474 feet.
- (3) Water Level 110 feet below top of ground.
- (4) Cased to 164', Size \_\_\_\_\_.
- (5) Screen: Size \_\_\_\_\_, Length \_\_\_\_\_.
- (6) Were any formations sealed against pollution?  
 yes, \_\_\_\_\_ no.

If YES depth of formation 164'

Why \_\_\_\_\_

Drillers Remarks: \_\_\_\_\_

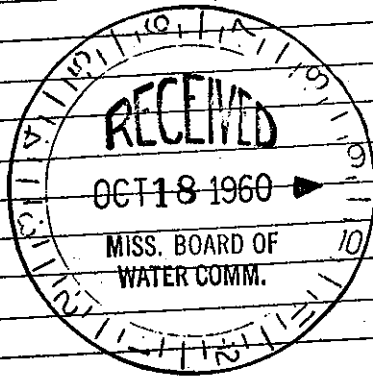

66 ✓ FILED 418

(Use Back Side)

Well No.

Mail this copy to Board of Water Commissioners 429 Miss. St. Jackson, Miss.