

MISSISSIPPI BOARD OF WATER COMMISSIONERS

LEE  
E 29  
9-6-60

WATER WELL DRILLERS LOG

300  
no location

Date: 9-6, 1960, Driller: Ewing Gas Co. County Lee

(1) Owner of Land: William Price  
(Name)  
Saltville, Miss.  
(Address)

(2) Location: NE 1/4, NW 1/4 Sec. 34 T 8 R 6 E  
(distance) (direction) (Nearest Town)

(3) Topography: \_\_\_\_\_  
(Hilly) (Flat) (Level)

(4) Purpose of Well: House hold  
(Domestic Irrigation, Municipal, Industrial, Other)

Description & Color of Materials Sand, Clay, Red Clay, Shell, etc.	Thick- ness Feet	Depth Feet
<u>Surface Clay</u>	<u>20</u>	<u>20</u>
<u>Red Clay</u>	<u>15</u>	<u>35</u>
<u>Shale</u>	<u>15</u>	<u>50</u>
<u>Blue Clay</u>	<u>30</u>	<u>80</u>
<u>Black water</u>		
<u>Shore of lignite</u>		

Information upon completion of well:

(1) Diameter 4 inches.

(2) Total Depth 390 feet.

(3) Water Level 110 feet below top of ground.

(4) Cased to 68', Size \_\_\_\_\_.


(5) Screen: Size \_\_\_\_\_, Length \_\_\_\_\_.

(6) Were any formations sealed against pollution?  
 yes, \_\_\_\_\_ no.

If YES depth of formation 68'

Why \_\_\_\_\_

Drillers Remarks: \_\_\_\_\_

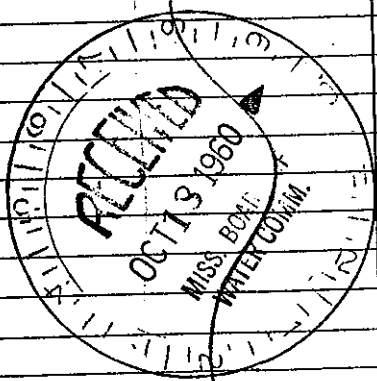

67 TELEU 380

(Use Back Side)

Well No.

Mail this copy to Board of Water Commissioners 429 Miss. St. Jackson. Miss